
Hodgeman

Form 51—5M—9-28—27423

Map No. KANSAS Sec. 30 Twp. 22 R. 22 W

Well No. 1 - Hoopeman Farm

Phillips Pet Company

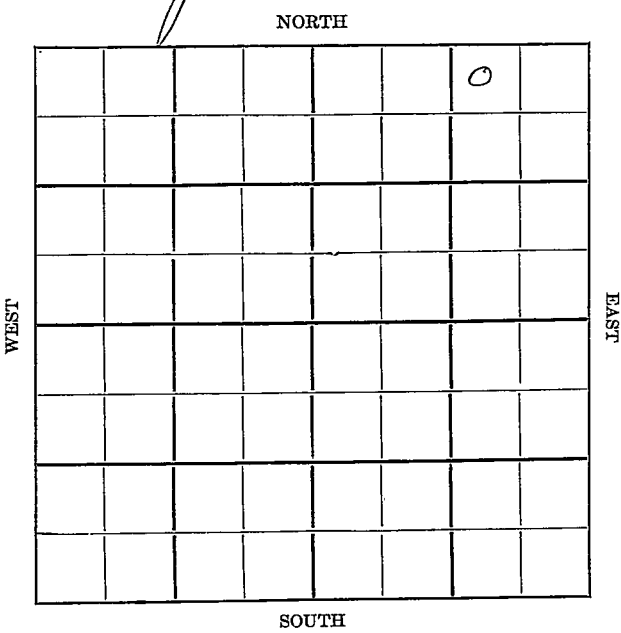

Location

Drilling Remarks

Rig Up

Drilling Remarks

2791

RECORD

Cased ..... in. ..... ft.

Sand

Gas

Oil

Total Depth

PRODUCTION

1st 24 hrs. Nat.

1st 24 hrs. after shot

Gas ..... cu. ft.

Dry Hole

Abandoned

Hodgeman

M-252A-5M-12-28-PETROL

Map No. KANSAS Sec. 30 Twp. 22 R. 22W

Well No. 1 Housman Farm


Phillips Pet Company

330 Ft. from N. Line

Ft. from S. Line

990 Ft. from E. Line

Ft. from W. Line

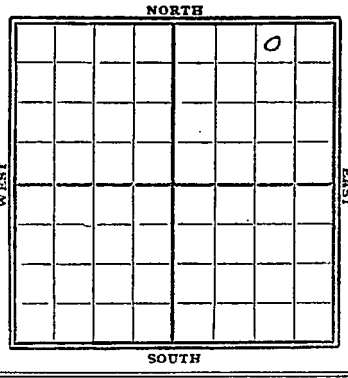

1929

Date	REPORT
5/29	Loc.
6/5	Bldg Rig
6/12	Rig
6/19	
6/26	
7/2	Spud
7/10	Rly 385'
7/17	" 750'
7/24	" 905'
7/31	" 1145
8/7	" 1445'
8/14	" 1600'
8/21	" 2005'
8/28	" 2750
9/4	" 3070
9/11	10"-3070
9/18	w.R. 8"-3327'
9/25	Rly 3440
10/2	" 3760'
10/8	" 3880'
10/16	6"-3967

10/23- HFW at 4040'
VIR 6"- 4064' TD.
10/30- Drlg 4191'
11/6- No Report
11/13 - Drlg 4250'
11/20 - " 4365
11/27 - VIR 6"- 4385
12/4 - Drlg 4415
12/11 - " 4620 show oil and 3 bailers water
12/18- VIR 6"- 4634' HFW
12/23 —
12/30 —
1930
1/8- S.D. 4634'
1/15 —
1/22- Drlg 4643' 6"- 4634 ~~4620~~'
1/29- " 4755' 6"- 4634
2/5- " 4895
2/12- VIR 7"- 4995'
2/19- —
2/26- 7"- 5005- Drlg. 5034.
3/5.- S.D. 5034
3/12- Run 5" at 5034'
3/19. —
3/26- HFW 5038'- T.D- 5039' S.D. for orders.
4/2- 5"- 5041
Drlg. 5047

Form 252A—5M—11-29—38055

Map No. _____ Sec. 30 Twp. 22 R. 22W

Well No. 1 – Houseman Farm


Phillips Pet. Company

330 Ft. from N. Line

_____ Ft. from S. Line

990 Ft. from E. Line

_____ Ft. from W. Line

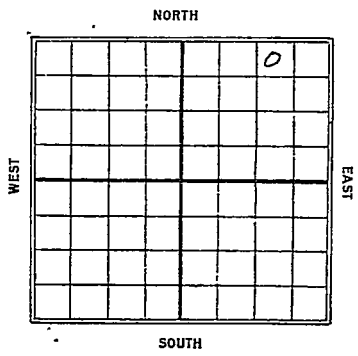

Date	REPORT
1930	
4/9	Ldrlg. 5101'
4/16	TD 5120
	Dry & Abandon

Form 26—1M Blk—9-28


Map No. KANSAS Sec. 30 Twp. 22 R. 22 W

Well No. 1 Houseman

Phillips Pet. Co. Company

Contractor

SECTION PLAT

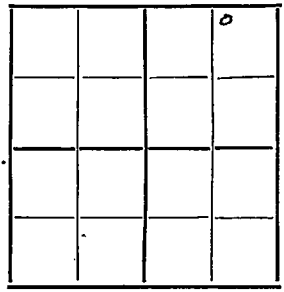

330 Ft. from N. Line

Ft. from S. Line

990 Ft. from E. Line

Ft. from W. Line

FIRST REPORTS

Location

Rig up

Drilling and Remarks:

R.O.G.

RECORD

Cased in., ft.

Sand

Gas

Oil

Total Depth

PRODUCTION

1st 24 hrs. Nat.

1st 24 hrs. after shot

Gas Cu. Ft.

Dry Hole

Abandoned

Date

MAY 29 1929

192

S. J. LEWIS Scout

Form 26—1M Bks. 9-28

Hoffman

Map No. KANSAS Sec. 20 Twp. 22 R. 22 W

79


Well No. 1 Hausenman

Phillips Pet.

Company

Contractor

SECTION PLAT

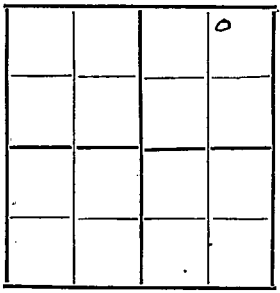

330 Ft. from N. Line

Ft. from S. Line

990 Ft. from E. Line

Ft. from W. Line

ABANDONED

Location

Rig up

Drilling and Remarks:

RECORD

Cased in., ft.

Sand

Gas

Oil

Total Depth 5120

PRODUCTION

1st 24 hrs. Nat.

1st 24 hrs. after shot

Gas Cu. Ft.

Dry Hole

Abandoned

Date

APR 16 1930

192

S. J. LEWIS Scout