


Finney KANSAS

SECTION 30 TOWNSHIP 22S RANGE 31W

WELL NO. #1 Trekell

COMPANY McKelvy

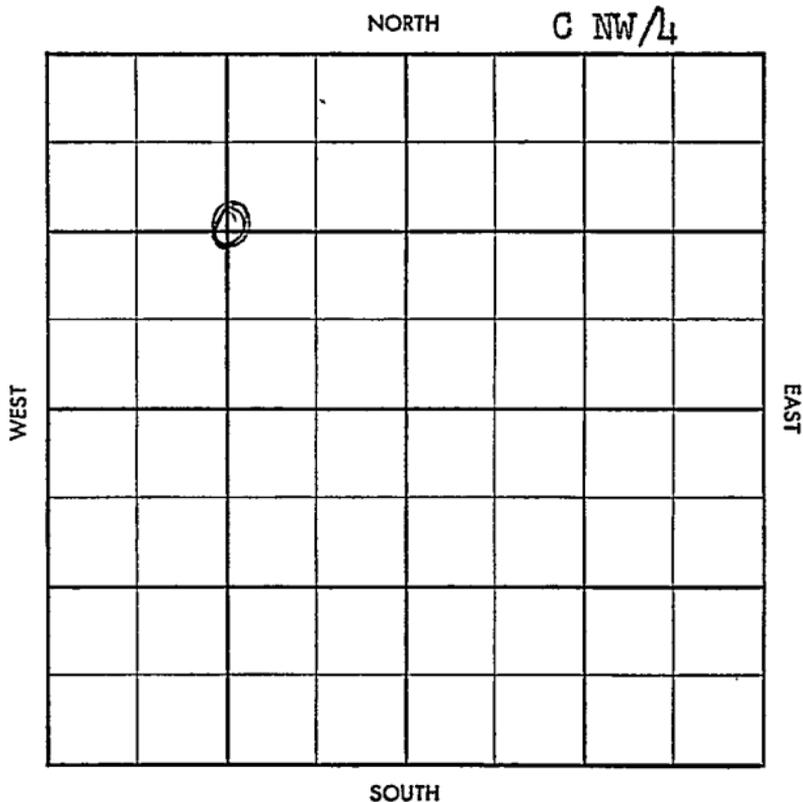

35

S-513-B

County Finney Elev. _____
 Sec. 30 Twp. 22 Rge. 31W
 Company McKelvy
 Farm Name Trekell No. 1

TOPS	DEPTH	LOG	DATUM
Anh.			
Tp.			
H.			
Tr.			
Dg.			
B.L.			
L.			
K.C.			
B.K.C.			
Ce.			
C.			
M.			
M.			
K.			
Mz.			
Mq.			
V.			
S.			
S.			
A.			
R.			
Pf.			
G.			
T.D.			

Loc. in Sec. _____
C NW/4
 Geol. _____
 Contr. _____
G-M #5
 Pool _____
Hugoton

JAN 29 1958
FIRST REPORT

Date Comm. _____
MIRT


Co.
 Lse.
 No.
 Sec.
 T.
 R.

S-513-B

County Finney Elev. 2930 DF 26288
 Sec. 30 Twp. 22 Rge. 31W
 Company McKelvey
 Farm Name Trekell No. 1

TOPS	DEPTH	LOG	DATUM
Anh.			
Tp. <u>Hwp</u>		<u>2682</u>	
H. <u>Roid</u>		<u>2710</u>	
Tr. <u>win</u>		<u>2762</u>	
Dg.			
B.L.			
L.			
K.C.			
B.K.C.			
Ce.			
C.			
M.			
M.			
K.			
Mz.			
Mq.			
V.			
S.			
S.			
A.			
R.			
Pf.			
G.			
T.D.	<u>2775</u>	<u>2772</u>	

Loc. in Sec. C NW/4
 Geol. _____
 Contr. _____
G-M #5
 Pool _____
Hugoton

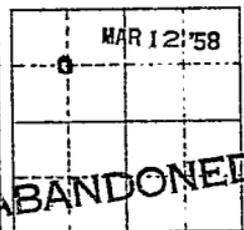

Date Comm. 1-30-58 2" 376/200
 MTRT FEB 5 58 5 1/2 2774/300 wict
 FEB 12 58 CD 2731 32/2712 -20 1/2
 MAR 12 58 free 5x5 ga 582 mcf + 520 gaw
ph gas decuse 158 mcf + 15 g wph
re huc 7x7 FU 300' w ph of TSTN

DoA

Co. No. Sec. No. Sec. T. R.