


Finney

KANSAS

SECTION 30 TOWNSHIP 22S RANGE 32W

WELL NO. #1 Ediger

COMPANY Kansas-Nebraska & Texas Co.

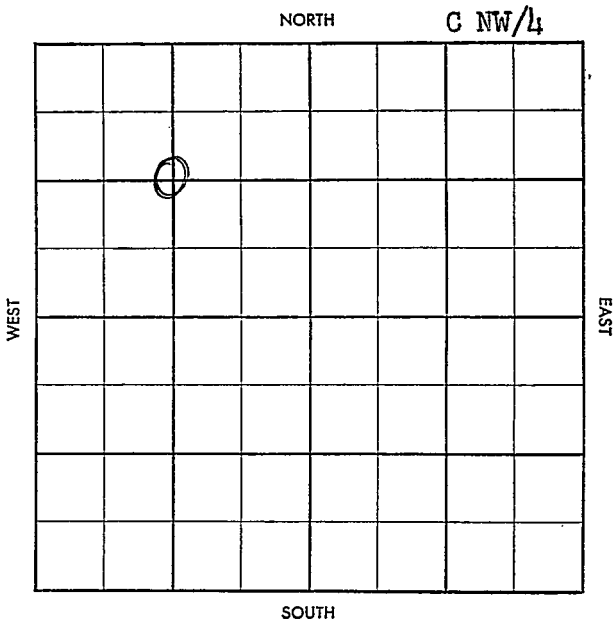

County Finney Elev. _____
 Sec. 30 Twp. 22 Rge. 32W
 Company Kansas-Nebraska & Texas Co.
 Farm Name Ediger No. 1

TOPS	DEPTH	LOG	DATUM
Anh.			
Tp.			
H.			
Tr.			
Dg.			
B.L.			
L.			
K.C.			
B.K.C.			
Ce.			
C.			
M.			
M.			
K.			
Mz.			
Mq.			
V.			
S.			
S.			
A.			
R.			
Pf.			
G.			
T.D.			

Loc. in Sec. _____


C NW/4

Geol. _____

Contr. _____

Honaker-Davi

Pool _____

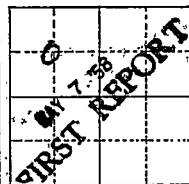HugotonDate Comm. 4-30-58 (Champlin - FO)8" @ 438 w/300, Drlg. 2100

Co.

Lsg

No.

Sec.

T.

R.

Twp. ~~X~~ Pool. ~~X~~

Co. ~~X~~ Facet. ~~X~~

S-513-B

County Finney Elev. 2660 = 286/26
 Sec. 30 Twp. 22 Rge. 32W
 Company Kansas-Nebraska & Texas Co.
 Farm Name Ediger No. 1

TOPS	DEPTH	LOG	DATUM
Anh. <u>Re</u>		<u>2533</u>	
Tp. <u>U. L. 2</u>		<u>2561</u>	
H. <u>L. L. 2</u>		<u>2585</u>	
Tr			
Dg.			
B.L.			
L.			
K.C.			
B.K.C.			
Ce.			
C.			
M.			
M.			
K.			
Mz.			
Mq.			
V.			
S.			
S.			
A.			
R.			
Pf.			
G.			
T.D.	<u>2625</u>	<u>2623</u>	

Loc. in Sec. C NW/4
 Geol. Honaker-Davis
 Contr. Hugoton
 Pool Hugoton

JUN 25 '58
 COMPLETE

Date Comm. 4-30-58 (Champlin - FO)
 8" @ 438 W/300, Drlg. 2100 MAY 14 '58 5 1/2
2624/200 wact MAY 21 '58 MAY 28 '58 JUN 3 '58
 JUN 11 '58 Co 48/2568-90 40/2592-2602
 1 ga 350 mcf + Ld 1 frac
 20x8 ga 4.25 mcf 10 hrs. ga
 3.720 mcf 24 hrs Tbg w JUN 18 '58
 JUN 25 '58 3.720 mcf 24 hrs B16
 Down NO pressures