

Finney


FORM 51

KANSAS

Section 30 Township 2 2 Range 33W

Well No. #1 G. City Unit "B"

Company Texas Company

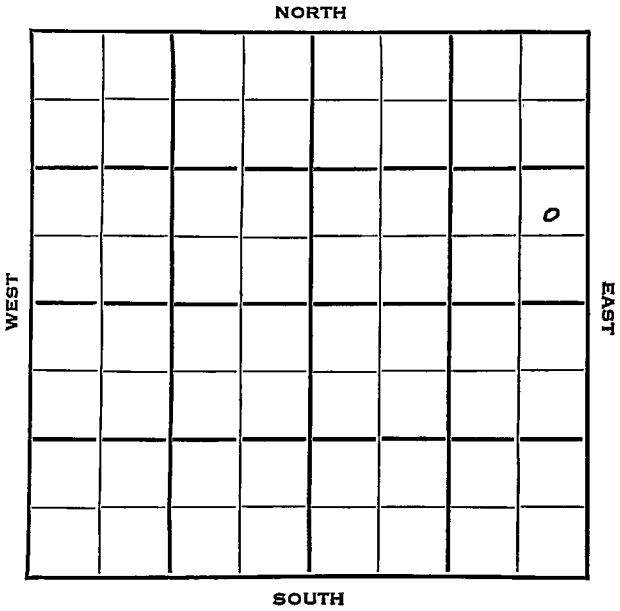

Finney KANSAS

SEC.	TWP.	R.
30	22	33W ✓

WELL NO.

I G. City Unit "B"

FARM

COMPANY

Texas Company

CONTRACTOR

Stickle Drlg.


Hugoton Pool

_____ Ft. from N. Line

1250 _____ Ft. from S. Line

50 _____ Ft. from E. Line

_____ Ft. from W. Line

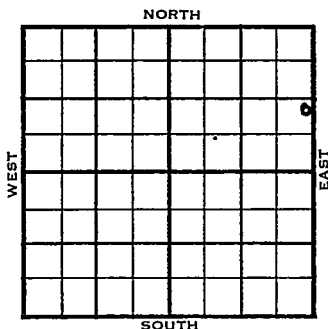

NE SE NE

	ELEVATION	REPORT
1954	2909'	

2/17 Spud 2-10-54
10" @ 512'
TD 2654'
7" @ 2653', WOC

2/24 Hol 2510', Her 2536 Kr 2558' Win
2596'

3/3 CO 2630
68/ 2538-72 2000 A frac 2000 A

3/10 Spud 2-10-54
Gas Well
TD 2654'
10" @ 512'
Hol. 2510', Her. 2536', Kri 2558',
Win 2596'
TD 2654'
7" @ 2653
CO to 2630, 68/2538-72, 2000A
Frac, 2000A
Comp. 10,684,000 gas

COMPLETED

County **Finney** State **Kansas**

Sec. **30** (Blk. **22** (Sur. **33W** Map No.

Operator Texas Company

Well No. 1 Farm G. City Unit "B"

Elev. 2909 Location NE SE NE

0

FIRST REPORT

1250Ft. From S Line NE

50 Ft. From E Line Quarter

1st. Report **FER 17 1954**

Completion _____

Remarks

Stickie Drlg. - Contr.

Spudding Date **2-10-54**

Drig. Data Hugoton Pool

10" @ 512 TD 2 654 7" @ 2653 WOC

J. G. McGEHEE