


Section 30 Township 22 Range 34W

Well No. #1 Biegert

Company Champlin Ref.

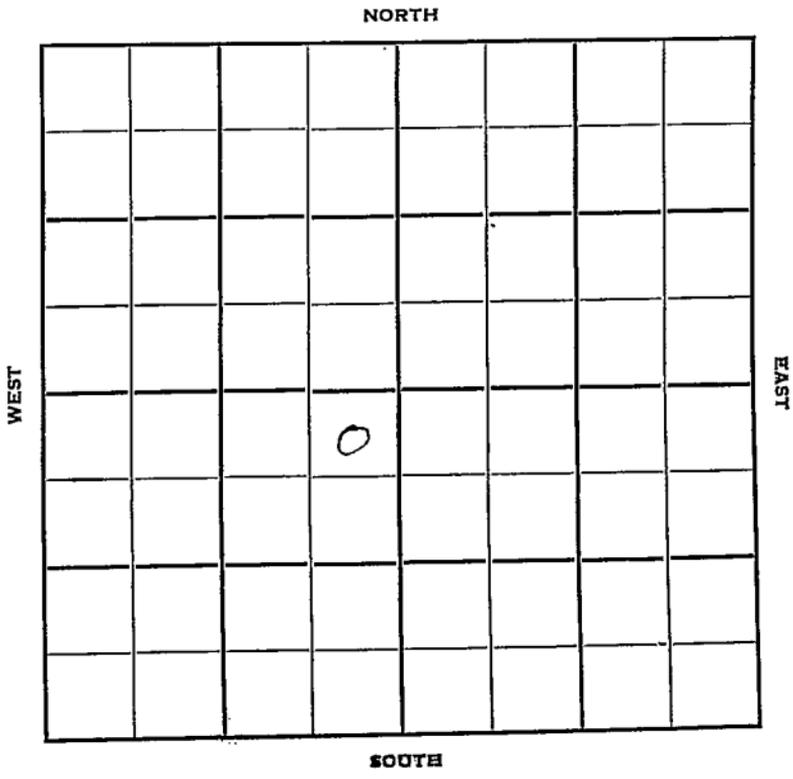

Sec. 30 Twp. 22 R. 34W

Well No. #1 Biegert. Farm

Champlin Ref. Company

Contractor


Hugoton Pool

330' Ft. from N. Line

Ft. from S. Line

330' Ft. from E. Line

Ft. from W. Line

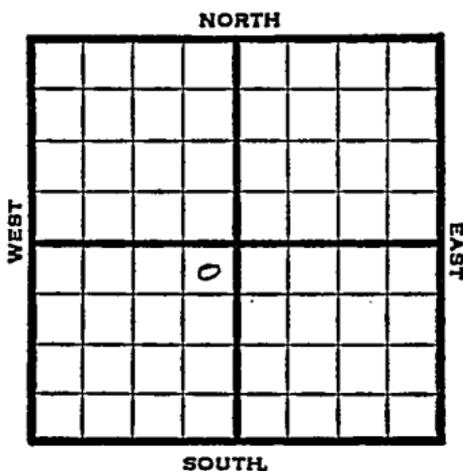

NE NE SW

1950 Elev 2993' REPORT

1/25 Location
 5/3 TD 2641'
 10 3/4" @ 600'
 Her 2498'
 Kr 2526'
 Winn 2586'
 7" @ 2500'
 1,926,000 CFGPD
 Comp

COMPLETED

Map No. _____ Sec. 30 Twp. 22 R. 34W

Well No. 1 Biegert

Champlin Ref.

Company

Contractor

NE NE SW


SECTION PLAT

330 Ft. from N. Line

Ft. from S. Line

330 Ft. from E. Line

Ft. from W. Line

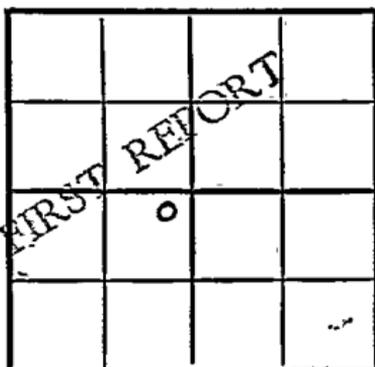

Finney County

Location X

Rig up

Drilling and Remarks:

RECORD

Cased _____ in., _____ ft.

Sand _____

Gas _____

Oil _____

Total Depth _____

PRODUCTION

1st 24 hrs. Nat. _____

1st 24 hrs. after shot _____

Gas _____ Cu. Ft.

Dry Hole _____

Abandoned _____

Date

JAN 25 1950 19

E. TYRA

Scout

Kansas

Map No. _____ Sec. 30 Twp. 22 R. 34WWell No. 1 Biegert

Champlin Ref. _____ Company _____

Contractor

NE NE SW

EI. 2993
SECTION PLAT330 Ft. from N. Line

_____ Ft. from S. Line

330 Ft. from E. Line

_____ Ft. from W. Line

	COMPLETE		
	O		

Finney County

Location _____

Rig up _____

Drilling and Remarks:

10 3/4" @ 60.0Nr 2498Nr. 2526Winn 25867" @ 25.001,926,000Date CFGPD

Date

MAY 3 1950

19

RECORD

Cased _____ in., _____ ft.

Sand _____

Gas _____

Oil _____

Total Depth 2641

PRODUCTION

1st 24 hrs. Nat. _____

1st 24 hrs. after shot _____

Gas _____ Cu. Ft.

Dry Hole _____

Abandoned _____

J. E. TYRA Scout