


Section 31 Township 22 Range 14W

Well No. #1 McMillan

Company Petroleum Inc.

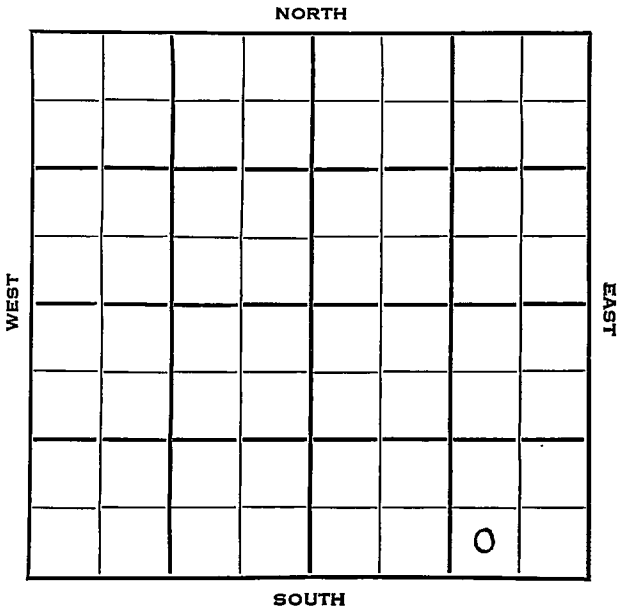

Stafford

KANSAS

SEC.	TWP.	R.
31	22	14W ✓

WELL NO.

1 McMillan

FARM

COMPANY

Petroleum, Inc.

CONTRACTOR

Garvey

Wildcat

Ft. from N. Line

330


Ft. from S. Line

990

Ft. from E. Line

Ft. from W. Line

SW SE SE

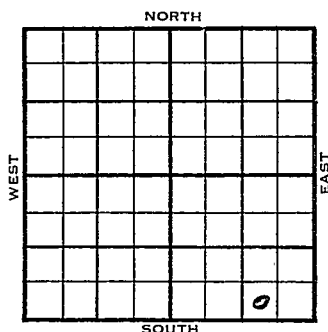

1953

ELEVATION

1968'

REPORT

9/30

Spud 9-18-53

8" @ 200'

Anhy 893', Heeb 3417', Tor 3439',

Doug 3455', Br. lime 3549', Lans 3560,

Simp 3934

DST 3944-66, opn $\frac{1}{2}$ hrs., rec. 10' mud, Off

Viola 3886', Cong. 3878', Arb. 4054'

Drlg. 4056'

10/7

Spud 9-18-53 D & A TD 4104'

8" @ 200' Anhy 893' Heeb 3417'

Tor 3439' Doug. 3455' Br lime 3549'

Lans 3560' Simp 3934'

DST 3944-66 open $\frac{1}{2}$ hr rec 10' mud Off

Viola 3886' Cong 3878' Arb. 4054'


TD 4104'

D & A

ABANDONED

J. G. McGEHEE

County Stafford State Kansas
 Sec. 31 (Blk.) 22 (Sur.) 14W Map No. _____
 Operator Petroleum Inc.
 Well No. 1 Farm McMillan
 Elev. 1968 Location SW SE SE

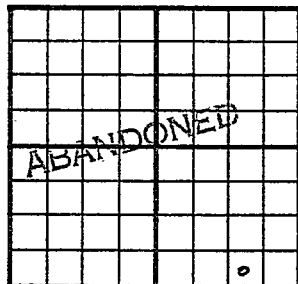

330 Ft. From S Line SE
990 Ft. From E Line Quarter
 Ist. Report _____
 Completion OCT 7 1953
 Remarks Wildcat
Garvey - Contr.
 Spudding Date 9-18-53

Drlg. Data D & A TD 4104
8" @ 200 Anhy 893 Heeb. 3417
Tor. 3439 Doug. 3455 Br. lime 3549
Lans. 3560 Simp. 3934 DST 3944-66
open $\frac{1}{2}$ hr. Rec. 10' mud O#
Viola 3886 Cong. 3878 Arb. 4054
TD 4104

D & A

J. G. McGEHEE