


Section 31 Township 22 Range 9 WWell No. #1 BallardCompany Cities Service

NORTH

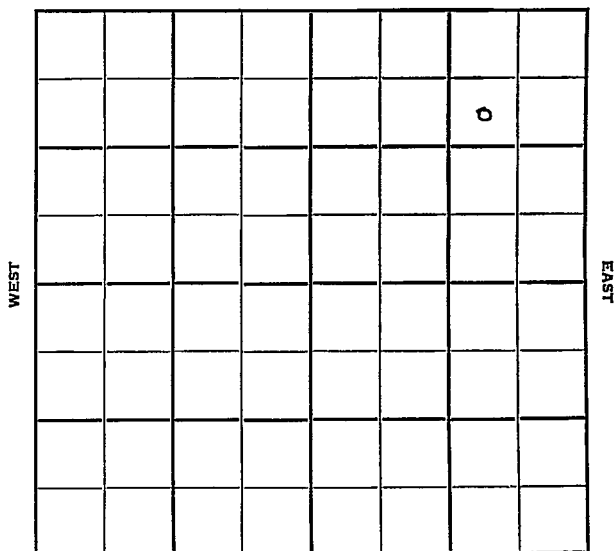

SOUTH

Sec. 31 Twp. 22 R. 9W

Well No. #1 Ballard Farm

Cities Service Company

Contractor

Peace Creek Pool


990' Ft. from N. Line

Ft. from S. Line

990' Ft. from E. Line

Ft. from W. Line

SW NE NE

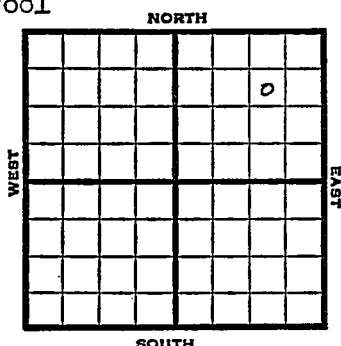

1951

Elev. 1724 REPORT

1/31

Spud 1-23-51
8" @ 266
Drlg. 3100'

2/21

Spud 1-23-51
D&A TD 3728
8" @ 266'
Br Lime 3152 Lans. 3190
Miss 3519 Kinderhook 3550
Viola 3695'
TD 3710 5" @ 3694
DD 3728 350' wtr
D&A

ABANDONED

County Reno State KansasSec. 31 (Blk. Twp.) 2 2 (Sur. Rge.) 9W Map No.Operator Cities ServiceWell No. 1 Farm BallardElev. Location SW NE NE

0

1ST REPORT

990 Ft. From N Line NE990 Ft. From E Line Quarter1st. Report JAN 31 1951

Completion

Remarks MCPC has SW of 30Spudding Date 1-23-51Drlg. Data Peace Creek Pool8" @ 266 drlg. 3100

J. E. TYRA

J. E. TYRA