

KANSAS

Reno


FORM 51 5M 10-41 PETROL

Section 31 Township 22 Range 9-W

Well No. #1 Ball

Company Cities Service Oil

NORTH Schweizer Pool

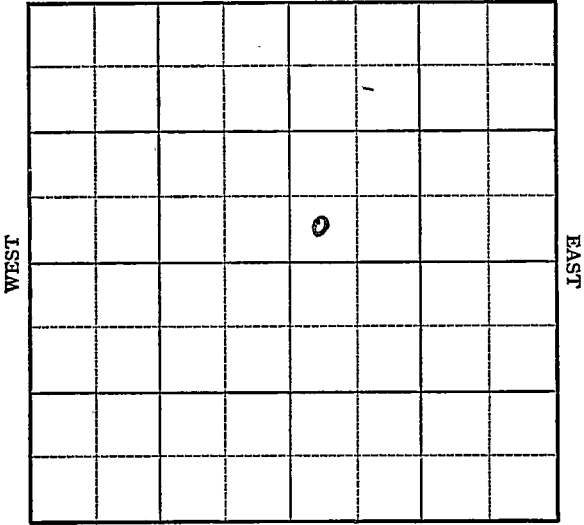

SOUTH

15-bbL

Sec. 31 Twp. 22 R. 9-W

Well No. #1 Ball Farm

Cities Service Oil Company

(Schweizer)


 Ft. from N. Line

330 Ft. from S. Line

 Ft. from E. Line

330 Ft. from W. Line

Elev. 1728

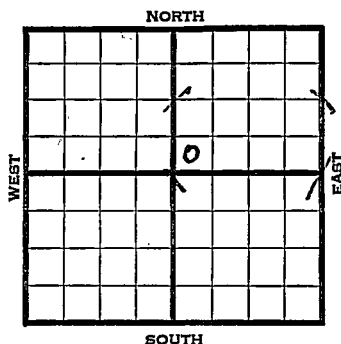

1942	REPORT
4/29	8" - 260' Drlg. 1385'
5/6	Drlg. 3200'
5/13	Viola ³⁷⁰⁵ 3704 T.D. 3705'
	5" - ³⁷⁰⁶ 3702 RUST.
5/20	Viola 3705' (Corrected) 5" - 3706'
	T.D. 3730' 600' water 2 hours.
	P.B. to 3714'
5/27	P.B. to 3714' 2000 acid.
	Temp. potential pump 45 oil & 96 wtr
	24 hours.
6/3	Viola 3705'
	5" - 3706'
	T.D. 3730'
	P.B. to 3714'
	2000 acid.
	Pump 144 oil & 316 water.
	42. Gravity
	COMPLETED


KANSAS

Reno

Map No. 49 Sec. 31 Twp. 22 R. 9WWell No. 1 BallCities Service Oil CompanyFIRST REPORT Contractor

SW NE

SECTION PLAT

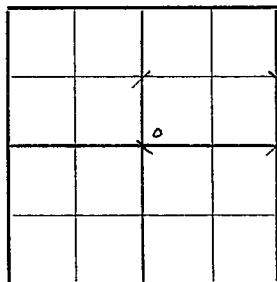 Ft. from N. Line330 Ft. from S. Line Ft. from E. Line330 Ft. from W. LineSCHWEIZER POOLLocation Rig up

Drilling and Remarks:

8" - 260'

Dr1g. 1385'

RECORD

Cased in., ft.Sand Gas Oil Total Depth

PRODUCTION

1st 24 hrs. Nat. 1st 24 hrs. after shot Gas Cu. Ft.Dry Hole Abandoned

Date

APR 29 1942 19 S. J. LEWIS Scout

Reno

KANSAS

Map No. 49 Sec. 31 Twp. 22 R. 9WWell No. 1 BallCities Service Oil CompanyCOMPLETED Contractor

S W NE

SECTION PLAT

 Ft. from N. Line330 Ft. from S. Line Ft. from E. Line330 Ft. from W. LineSCHWEIZER POOLLocation Rig up

Drilling and Remarks:

Vista 3705
5" 3706
PB 3714
2000 acid
Pump 144 oil 6 7 316
Watered Pk.
42° ge

RECORD

Cased in., ft.Sand Gas Oil Total Depth 3730

PRODUCTION

1st 24 hrs. Nat. 1st 24 hrs. after shot Gas Cu. Ft.Dry Hole Abandoned

Date

JUN 3 1942 19S. J. LEWIS Scout