

KANSAS

Reno


FORM 51 5M 4-41 PETROL

Section 31 Township 22 Range 9-W

Well No. #3 Schweizer

Company Hinkle Oil et al

NORTH Peace Creek Pool

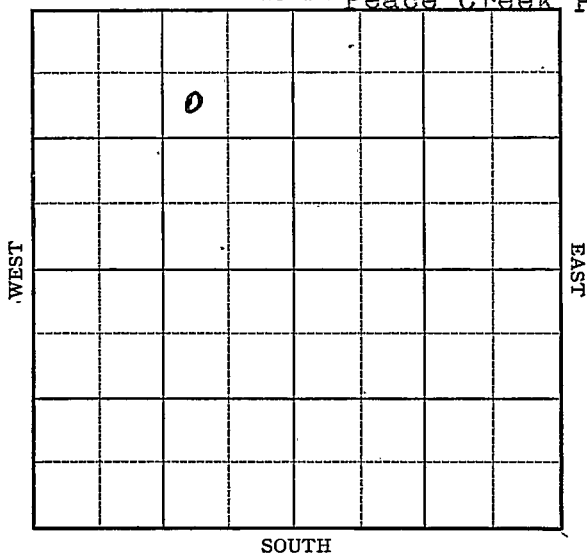

KANSAS

Reno

Sec. 31 Twp. 22 R. 9-WWell No. #3 Schweizer FarmHinkle Oil et al Company

(Peace Creek)


990 Ft. from N. Line

Ft. from S. Line

990 Ft. from E. Line

Ft. from W. Line

Elev. 1730

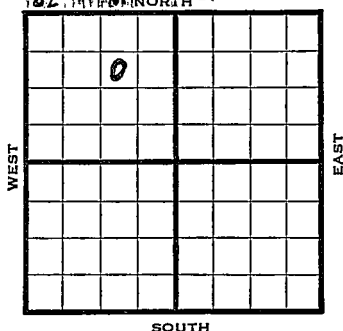

1942

REPORT

6/24	Location	
7/1	10" - 240' WOC.	
7/8	Drlg. 2110'	
7/15	Drlg. 3395'	
7/22	Viola 3682-3711' T.D. 5" - 3711' RUST.	
7/29	T.D. 3716	Flow 60 oil 3/4 hrs 1000 acid.
8/5	Flow 65 oil 3/4 hrs.	
8/12	" "	" "
8/19	Viola 3682'	5" - 3711'
	T.D. 3716	1000 acid
	Pump 425 Pot.	
	Gravity 42.	

COMPLETED

Reno

KANSAS

Map No. 49 Sec. 31 Twp. 22 R. 9WWell No. 3 SchweizerHinkle Oil et al. Company**FIRST REPO** Contractor

SW NE NW

SECTION PLAT

	0		

990 Ft. from N. Line Ft. from S. Line990 Ft. from E. Line Ft. from W. Line

PEACE CREEK POOL

Location XXXRig up

Drilling and Remarks:

RECORD

Cased in., ft.Sand Gas Oil Total Depth

PRODUCTION

1st 24 hrs. Nat. 1st 24 hrs. after shot Gas Cu. Ft.Dry Hole Abandoned

Date

JUN 24 1942

19


S. J. LEWIS

Scout

Map No. 49 Sec. 31 Twp. 22 R. 9WWell No. 3 SchweizerHinkle Oil etal. CompanyCOMPLETED Contractor

SW NE NW

SECTION PLAT

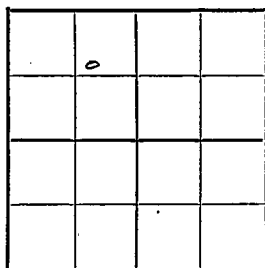990 Ft. from N. Line Ft. from S. Line990 Ft. from E. Line Ft. from W. Line

PEACE CREEK POOL

Location Rig up

Drilling and Remarks:

Vista 8652
5" @ 3711
1000 acid
Pump 425 P & T

Date

RECORD

Cased in., ft.Sand Gas Oil Total Depth 3216

PRODUCTION

1st 24 hrs. Nat. 1st 24 hrs. after shot Gas Cu. Ft.Dry Hole Abandoned

AUG 19 1942

S. J. LEWIS Scout