

93

KANSAS


FORM 51 5M 10-41 PETROL

Reno

Section 31 Township 22 Range 9-W

Well No. 1 Schweizer

Company Hinkle Oil & Central petr.

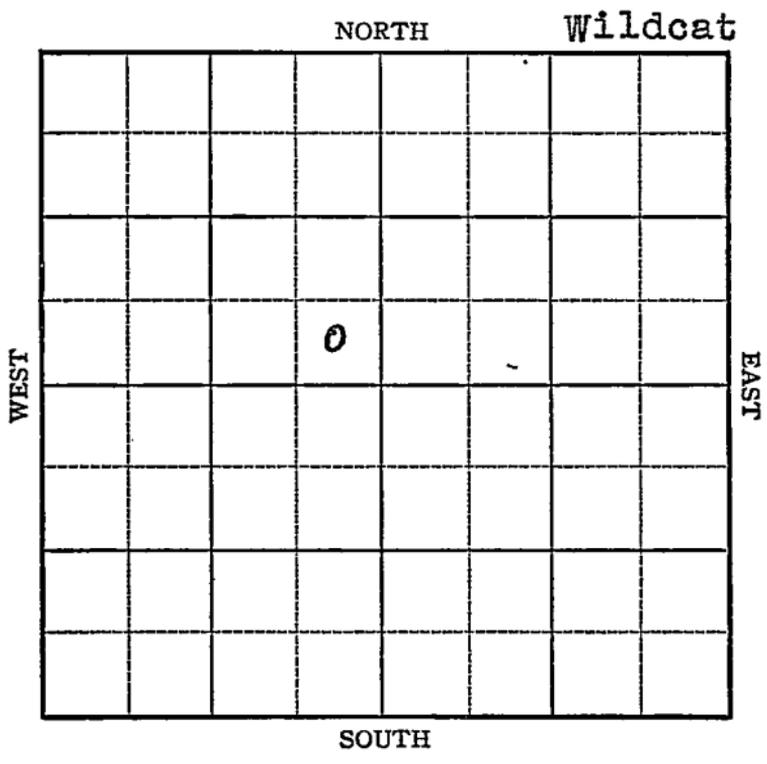


June - 850 bbls
30 acm

Sec. 3E Twp. 22 R. 9-W

Well No. #1 Schweizer Farm

Hinkle Oil & Central Petr. Company

(Wildcat)

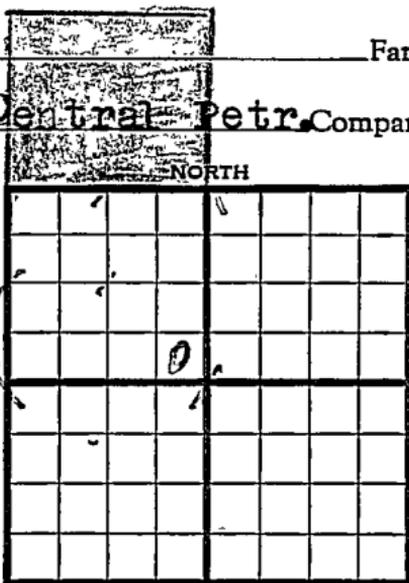

_____ Ft. from N. Line

330 Ft. from S. Line

330 Ft. from E. Line

_____ Ft. from W. Line

Elev. 1726

1941	REPORT
12/3	Derrick.
12/11	Surface Hole.
12/18	10" @ 269 Drlg. 2860
12/22	Top Viola 3702 Show oil to 3721 (Nice saturation in cuttings) T.D. 3725 Running pipe (Tel)
12/24	Lans. 3200' Kind. 3567' Misener 3675' Viola 3702' T.D. 3725' 5" - 3720' RUST.
12/31	Drilled plugs Swab 45 bbls. oil in 6 hours plus 5 to 15% water Think water is bottom hole water Swabbing off bottom Will acidize (Tel)
1942	
1/8	500 acid. Swab 25. oil per hour 8 hours.
1/15	Swab & flow 45 oil 1 hor, 5% water.
1/22	" " "
	OVER

1942

1/29

T.D. 3725'

. Swab & flow 45 oil 1 hour, 5% water.

2/5

" " " "

2/11

Viola 3702'

5" - 3720'

T.D. 3725'

500 acid.

Pump 774 oil & 31 $\frac{1}{2}$ water, potential.

42.8 Gravity

COMPLETED

Map No. 49 Sec. 31 Twp. 22 R. 9WWell No. 1 SchweizerHinkle Oil & Central Company
Petroleum

FIRST REPORT

Contractor


SE NW

_____ Ft. from N. Line

330 Ft. from S. Line330 Ft. from E. Line

_____ Ft. from W. Line

SECTION PLAT

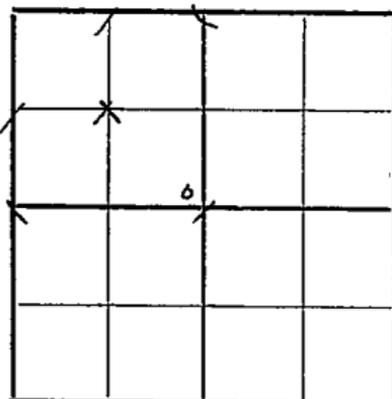

WILDCAT

Location _____

Rig up _____

Drilling and Remarks:

Derrick

RECORD

Cased _____ in., _____ ft.

Sand _____

Gas _____

Oil _____

Total Depth _____

PRODUCTION

1st 24 hrs. Nat. _____

1st 24 hrs. after shot _____

Gas _____ Cu. Ft.

Dry Hole _____

Abandoned _____

Date

DEC 3 1941 19

S. J. LEWIS Scout

Reno

KANSASMap No. 49 Sec. 31 Twp. 22 R. 9WWell No. 1 SchweizerHinkle Oil & Central Company

Petr.

COMPLETED

Contractor

SE NW

SECTION PLAT

_____ Ft. from N. Line

330 Ft. from S. Line330 Ft. from E. Line

_____ Ft. from W. Line

SCHWEIZER POOL

Location _____

Rig up _____

Drilling and Remarks:

*Viola 3702.**5" @ 3720**500 acid**Pump .774 oil**7 @ 1/2 Water Prod.**42 E Gr*

RECORD

Cased _____ in., _____ ft.

Sand _____

Gas _____

Oil _____

Total Depth 3225

PRODUCTION

1st 24 hrs. Nat. _____

1st 24 hrs. after shot _____

Gas _____ Cu. Ft.

Dry Hole _____

Abandoned _____

Date

FEB 11 1942 19S. J. LEWIS Scout