

KANSAS

FORM 51 5M 10-41 PETROL


Reno

Section 31 Township 22 Range 9-W

Well No. #1 Schweizer

Company Stanolind

Peace Creek Pool NORTH

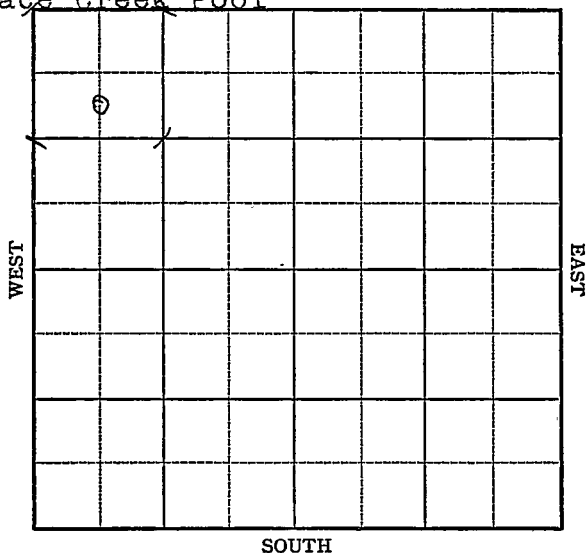

Sec. 31 Twp. 22 R. 9-WWell No. #1 Schweizer Farm

Stanolind

Company

(Peace Creek Pool)

990


Ft. from N. Line

Ft. from S. Line

Ft. from E. Line

660

Ft. from W. Line

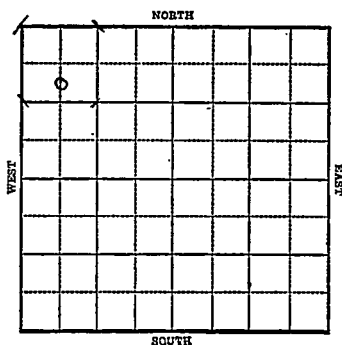Elev. 1730'

1942

R E P O R T

10/7

Derrick

10/14

"

10/21

13" @ 255 Drlg 1815'

10/28

3274 Drlg.

11/4

Viola 3674

SO 3699-3700

TD 3711

Run 7"

11/11

7" @ 3698' Rust

11/18

500 acid

swabb 90 oil in 2 hrs off bottom

2000 acid

11/24

Swab 27' oil per hr. 3 hr.

150' off bottom.

12/2

Viola 3674

7" @ 3698'

2500 Acid

T.D. 3711'

Bomb. Pot. 1085 plus 15% water

Gravity 42

COMPLETED

Reno

KANSAS

Map No. 19 Sec. 31 Twp. 22 R. 9WWell No. 1 Schweizer

Stanolind

Company

FIRST REPORT

Contractor

C SL NW NW


990 Ft. from N. Line

Ft. from S. Line

Ft. from E. Line

660 Ft. from W. Line

SECTION PLAT

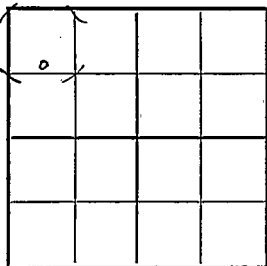

PEACE CREEK POOL

Location

Rig up

Drilling and Remarks:

Derrick

RECORD

Cased _____ in., _____ ft.

Sand _____

Gas _____

Oil _____

Total Depth _____

PRODUCTION

1st 24 hrs: Nat. _____

1st 24 hrs. after shot: _____

Gas _____ Cu. Ft.

Dry Hole _____

Abandoned _____

Date

OCT 7 1942 19


S. J. LEWIS Scout

KANSAS Reno
 Map No. 49 Sec. 31 Twp. 22 R. 9W
 Well No. 1 Schweizer

Stanolind Company
COMPLETED Contractor

C SL NW NW

SECTION PLAT

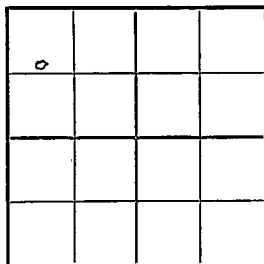990 Ft. from N. Line Ft. from S. Line Ft. from E. Line660 Ft. from W. Line

PEACE CREEK POOL.

Location Rig up

Drilling and Remarks:

Vista 36747" C36982500 acidBore & P2 1088+ 15% Water42 c/g

RECORD

Cased in., ft.Sand Gas Oil Total Depth 3711

PRODUCTION

1st 24 hrs. Nat. 1st 24 hrs. after shot Gas Cu. Ft.Dry Hole Abandoned

Date

DEC 2 1942 19 S. I. LEWIS Scout