

Stafford

Map No. KANSAS Sec. 31 Twp 22 R. 11W

Well No. 3-Allen Farm


Stanolind O-G. Company

990 Ft. from N. Line

_____ Ft. from S. Line

_____ Ft. from E. Line

990 Ft. from W. Line

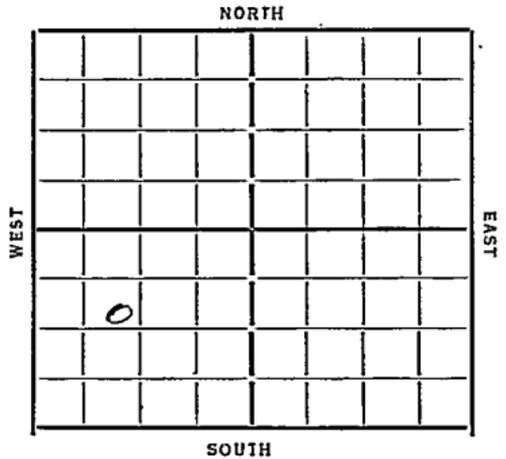

Date

REPORT

1934

1/24 location

1/31 —

2/7 13" 220 woc

2/14 Dydg 2628

2/23 Leasing 3242 Coring 3375

3/1 7" 3536 sil. 3536 woc

3/8 Bailing

3/15 7.5 3578 Pump 1330 Bbls
24 hrs.

3/31 Silicious 3536 7.5 3578
895 Bbls.

COMPLETED

Map No. 46 Sec. 31 Twp. 22 R. 11W

Well No. 3- Allen

Stanolind Oil Company

Contractor

FIRST REC'D

SECTION PLAT

990 Ft. from N. Line

..... Ft. from S. Line

..... Ft. from E. Line

990 Ft. from W. Line

| | | | |
|--|---|--|--|
| | | | |
| | | | |
| | | | |
| | 0 | | |
| | | | |

Location

Rig up.....

Drilling and Remarks:

RECORD

Cased..... in., ft.

Sand.....

Gas.....

Oil.....

Total Depth.....

PRODUCTION

1st 24 hrs. Nat.....

1st 24 hrs. after shot.....

Gas..... Cu. Ft.

Dry Hole.....

Abandoned.....

Date

1-24-34 192

O. Mansfield Scout

Stafford

Map No. 46 Sec. 31 Twp. 22 R. 11W

Well No. 3-Allen

Stanolind O + H Company

Contractor

COMPLETE

SECTION PLAT

990 Ft. from N. Line

_____ Ft. from S. Line

_____ Ft. from E. Line

990 Ft. from W. Line

| | | | |
|--|--|--|--|
| | | | |
| | | | |
| | | | |
| | | | |

Location _____

Rig up _____

Drilling and Remarks:

895 bbls

RECORD

Cased _____ in., _____ ft.

Sand Mucous 3536

Gas _____

Oil _____

Total Depth 3578

PRODUCTION

1st 24 hrs. Nat. _____

1st 24 hrs. after shot _____

Gas _____ Cu. Ft.

Dry Hole _____

Abandoned _____

Date

3/24/34 19 O. Manschreck Scout