


Section 31 Township 22 Range 11-W
Well No. 3 - Elmer Allen
Company Stanolind

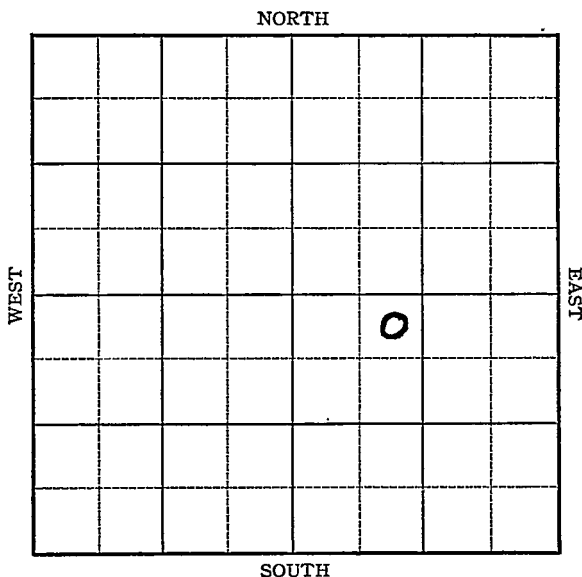

1937

10/13 6" @ 3569'.

Sil. 3570'.

T.D. 3609" .

6500 acid (Total)

Shot 10 qts.

Pot. 83 bbls.

COMPLETED

Map No. _____ Sec. 31 Twp. 22 R. 11 ^W

Well No. 3- Elmer Allen

Stanolind Company

Contractor

FIRST REPORT

330 Ft. from N. Line

_____ Ft. from S. Line

_____ Ft. from E. Line

990 Ft. from W. Line

SECTION PLAT

		0	

Location _____

Rig up _____

Drilling and Remarks:

R. U. R.

RECORD

Cased _____ in., _____ ft.

Sand _____

Gas _____

Oil _____

Total Depth _____

PRODUCTION

1st 24 hrs. Nat. _____

1st 24 hrs. after shot _____

Gas _____ Cu. Ft.

Dry Hole _____

Abandoned _____

Date

AUG 4 - 1937 19

H. D. Hatfield

Scout

Stafford **KANSAS**Map No. _____ Sec. 31 Twp. 22 R. 11WWell No. 3 Elmer AllenStanolind Company

Contractor _____

COMPLETED

NE NW SE

330 Ft. from N. Line

_____ Ft. from S. Line

_____ Ft. from E. Line

990 Ft. from W. Line**SECTION PLAT**

		0	

Location _____

Rig up _____

Drilling and Remarks:

6500 Acid (Total)
shot 10 gts

POT-83

RECORDCased 6 in., 3569 ft.Sand 511 3570

Gas _____

Oil _____

Total Depth 3609**PRODUCTION**

1st 24 hrs. Nat. _____

1st 24 hrs. after shot _____

Gas _____ Cu. Ft.

Dry Hole _____

Abandoned _____

Date

OCT 13 1937 19 E. D. Hatfield Scout