FORM 51 10M 7-48 PETROL

KANSAS


Stafford

Section 31 Township 22 Range 11W

Well No. 1 Heyen

Company Musgrove Pet.

Richardson Pool

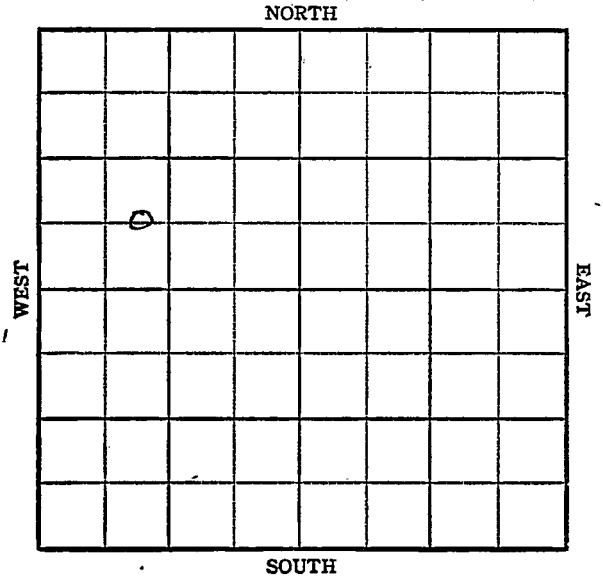

FORM 252-A
5M 10-48 PETROL

KANSAS


Stafford ✓

Sec. 31 Twp. 22 R. 11W

Well No. #1 Heyen Farm

Musgrove Pet. Company

Richardson Pool

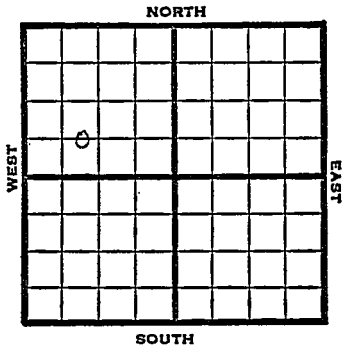

_____ Ft. from N. Line

660' Ft. from S. Line

_____ Ft. from E. Line

990' Ft. from W. Line

C E L SW NW

1948	REPORT
	Eli 1816'
11/23	8" @ 266'
12/1	TD 3626' in Cong.
	Cong 3544'
	Aband.
	ABANDONED

Form 26 200 Bks. 9-48 Petrol

Kansas

Richardson Pool

Map No. _____ Sec. 31 Twp. 22 R. 11W


Well No. 1 Heyen

Musgrove Pet. Company

FIRST REPORT Contractor

C E L SW NW

SECTION PLAT

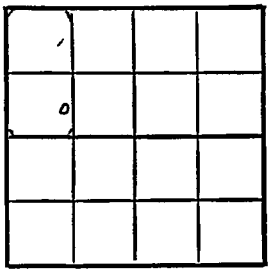

_____ Ft. from N. Line

660 Ft. from S. Line

_____ Ft. from E. Line

990 Ft. from W. Line

Stafford County

Location _____

Rig up _____

Drilling and Remarks:

8" @ 266

RECORD

Cased _____ in., _____ ft.

Sand _____

Gas _____

Oil _____

Total Depth _____

PRODUCTION

1st 24 hrs. Nat. _____

1st 24 hrs. after shot _____

Gas _____ Cu. Ft.

Dry Hole _____

Abandoned _____

Date

NOV 23 1948 19

S. J. LEWIS Scout

Form 26 200 Bks. 9-48 Petrol

Kansas

Richardson Pool

Map No. 46 Sec. 31 Twp. 22 R. 11W

Well No. 1 Heven


Musgrove Pet. Company

ABANDONED Contractor

C E L SW NW

El. 1876

SECTION PLAT

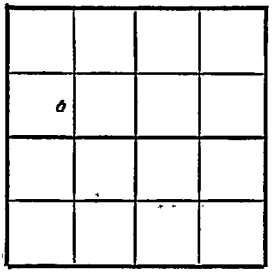

____ Ft. from N. Line

660 Ft. from S. Line

____ Ft. from E. Line

990 Ft. from W. Line

Stafford County

Location

Rig up

Drilling and Remarks:

Comp 3544

RECORD

Cased ____ in., ____ ft.

Sand

Gas

Oil

Total Depth 3626 in Conq

PRODUCTION

1st 24 hrs. Nat.

1st 24 hrs. after shot

Gas ____ Cu. Ft.

Dry Hole

Abandoned

Date

DEC 1 1948 19

S. J. LEWIS Scout