


Map No. **KANSAS** Sec. **31** Twp. **22** R. **11W**
 Well No. **3-1 Deep** Farm
Stanley O & G. Company

NORTH

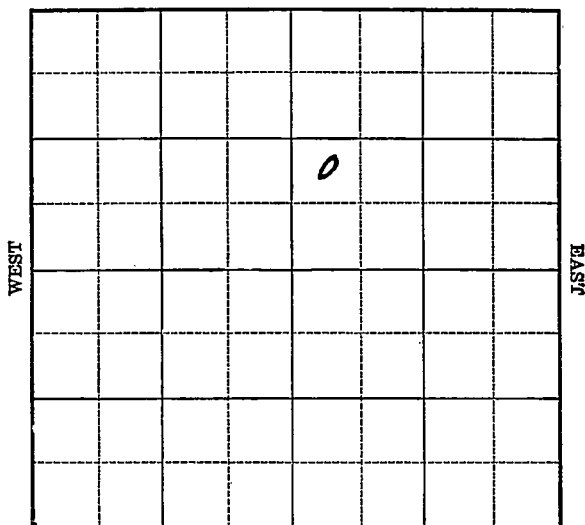

SOUTH

Location _____

Drilling Remarks _____

Rig Up _____

Drilling Remarks _____

RECORD

Cased _____ in. _____ ft.

Sand _____

Gas _____

Oil _____

Total Depth _____

PRODUCTION

1st 24 hrs. Nat. _____

1st 24 hrs. after shot _____

Gas _____ cu. ft.

Dry Hole _____

Abandoned _____


KANSAS

Map No. _____ Sec. 31 Twp. 22 R. 11 W

Well No. 3-Heper Farm _____

Stanlink Oil Co. Company _____

NORTH

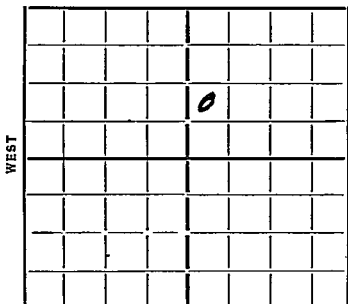

_____ Ft. from N. Line

990 Ft. from S. Line

_____ Ft. from E. Line

330 Ft. from W. Line

Elev. 1815

SOUTH

Date 1935

REPORT

5/8 Location
5/16
5/23 Rot Rig
5/29
6/6 13" 220 WOC
6/13 Bly 1960
6/20 K@ 3231 Coring
6/28 Sig 3518 T7 3521 Oil
7/3 Dry sand line
7/11 Pals 3521-30 3000 Oil
7/17 2 hrs Tubing
Sig 3518
Oil 3521-30
T7 3530
1300 Bbls

COMPLETED

Map No. 46 Sec. 31 Twp. 22 R. 11W

Well No. 3-Heyen

Stanolind O & M. Company

Contractor

FIRST REPORTS

SECTION PLAT

		0	

Ft. from N. Line

990 Ft. from S. Line

Ft. from E. Line

330 Ft. from W. Line

Location ☒

Rig up

Drilling and Remarks:

RECORD

Cased.....in.,ft.

Sand.....

Gas.....

Oil.....

Total Depth.....

PRODUCTION

1st 24 hrs. Nat.....

1st 24 hrs. after shot.*.....

Gas.....Cu. Ft.

Dry Hole.....

Abandoned.....

Date

ORVAL MANNSCHRECK

5-8-35 192

Scout

Map No. 46 Sec. 31 Twp. 22 R. 11WWell No. 3-HeyenManohnd Company

Contractor

SECTION PLAT

		0	

Ft. from N. Line

990 Ft. from S. Line

Ft. from E. Line

330 Ft. from W. Line

Location

Rig up

Drilling and Remarks:

RECORD

Cased in. ft.

Sand Sil 3518

Gas

Oil 3521-30Total Depth 3530

PRODUCTION

1st 24 hrs. Nat.

1st 24 hrs. after shot

Gas Cu. Ft.

Dry Hole

Abandoned

Date

ORVAL MANN-CHECK

7-17-35 192

Scout