


Stafford

Map No. *1-1* Sec. *31* Twp. *22* R. *11W*

Well No. *1-A Heizer* Farm
Standard Oil Co. Company

_____ Ft. from N. Line
990 Ft. from S. Line
330 Ft. from E. Line
_____ Ft. from W. Line

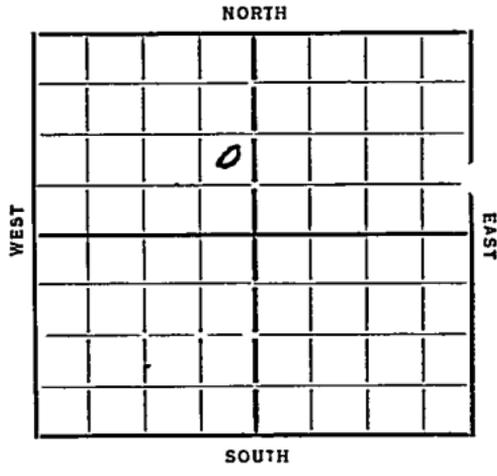

Date *1935*

REPORT

<i>2/6</i>	<i>Cellar</i>
<i>2/13</i>	<i>Rig</i>
<i>2/21</i>	<i>Log 400</i>
<i>2/28</i>	<i>" 7545</i>
<i>3/7</i>	<i>2963 log pipe stuck</i>
<i>3/14</i>	<i>log 3370 Lancing 3234</i>
<i>3/21</i>	<i>S.O. 3380-82 7" 3378 WOC</i>
<i>4/4</i>	<i>Ramp 3517 Sil 3519</i>
<i>4/11</i>	<i>4/4 - 4/11 - 4/18</i>
<i>4/26</i>	<i>3545 T 17 Hook 360 Bbls Thru Tubing</i>
<i>5/1</i>	<i>Sil 3519 T 70 3545 1132 Bbls 27 hrs.</i>

COMPLETED

Stafford

Lanon

Map No. *46* Sec. *31* Twp. *22* R. *11W*

Well No. *1A-Heyew*

Stanolind O & A Company

Contractor

FIRST REPORTS

SECTION PLAT

Ft. from N. Line

990

Ft. from S. Line

330

Ft. from E. Line

Ft. from W. Line

	<i>0</i>		

Location.....

Rig up.....

Drilling and Remarks:

cellar

RECORD

Cased..... in., ^f..... ft.

Sand.....

Gas.....

Oil.....

Total Depth.....

PRODUCTION

1st 24 hrs. Nat.....

1st 24 hrs. after shot.....

Gas..... Cu. Ft.

Dry Hole.....

Abandoned.....

Date

2-6-35

192.....

ORVAL MANSCHRECK
Scout

Map No. 46 Sec. 31 Twp. 22 R. 11W

Well No. 1A - Hesper

Stanolind Oil & Gas Company

Contractor

COMPLETED

SECTION PLAT

	0		

Ft. from N. Line

990 Ft. from S. Line

330 Ft. from E. Line

Ft. from W. Line

Location

Rig up

Drilling and Remarks:

1132 hpb
22 hrs

RECORD

Cased _____ in., _____ ft.

Sand Sil 3519

Gas _____

Oil _____

Total Depth 3545

PRODUCTION

1st 24 hrs. Nat. _____

1st 24 hrs. after shot _____

Gas _____ Cu. Ft.

Dry Hole _____

Abandoned _____

Date

ORVAL MANSCHRECK

5-1-35 192

Scout