


Section 31 Township 22 Range 11-W

Well Number 6 Hyen "B" (Heyen)

Company Stanolind

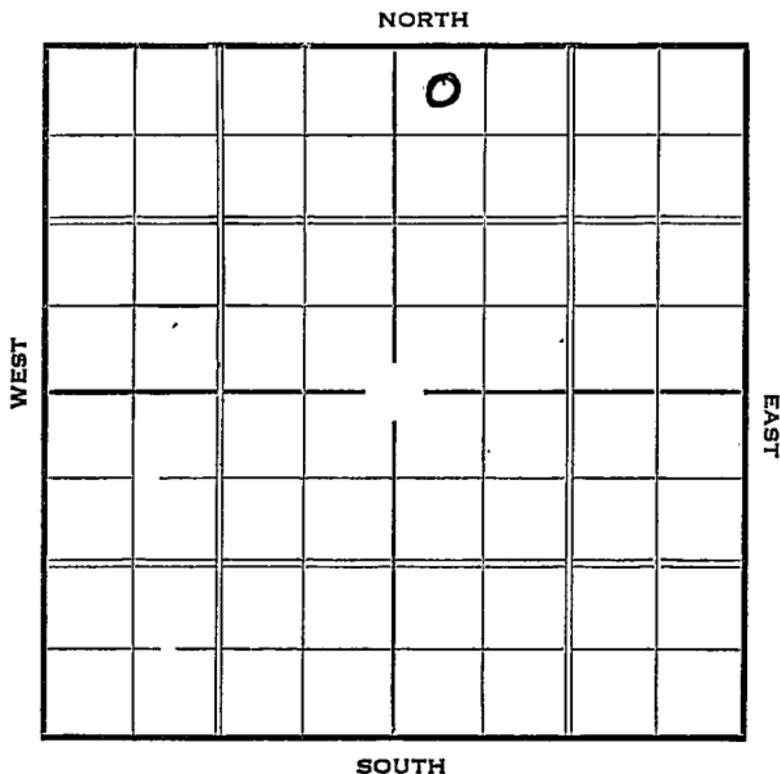

Sec. 31 Twp. 22 R. 11W

Well No. 6 Hyen "B" Farm

Stanolind Company


330 Ft. from N. Line

_____ Ft. from S. Line

_____ Ft. from E. Line

330 Ft. from W. Line

Elev. 1817

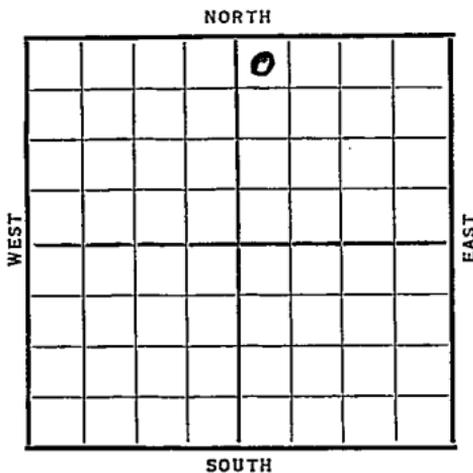

Date	REPORT
1/27	Rig
2/4	"
2/11	Rigging up
2/18	12" @ 219'. Drlg. 1675'.
2/26	Drlg. 3007'
3/4	Sil 3529'. 7" @ 3529'.
	Drlg. 3532'
3/11	T.D. 3532 RUST
3/18	" " "
3/25	T.D. 3560' swabb 50 bbls. per hour.
3/31	Sil. 3529'.
	T. D. 3560'.
	Potential 1530.
COMPLETED	

KANSAS

Map No. 46 Sec. 31 Twp. 22 R. 11W

Well No. 6 Hgen "B"

Standford Company

Contractor

SECTION PLAT

		0	

330 Ft. from N. Line

_____ Ft. from S. Line

_____ Ft. from E. Line

330 Ft. from W. Line

FIRST REPORT

Location _____

Rig up _____

Drilling and Remarks:

Rig

RECORD

Cased _____ in., _____ ft.

Sand _____

Gas _____

Oil _____

Total Depth _____

PRODUCTION

1st 24 hrs. Nat. _____

1st 24 hrs. after shot _____

Gas _____ Cu. Ft.

Dry Hole _____

Abandoned _____

Date

JAN 27 1937 19

S. J. LEWIS

Scout

KANSAS *Stafford*

Map No. 46 Sec. 31 Twp. 22 R. 11W.

Well No. 6 Heyen "B"

Stanford Company

Contractor

SECTION PLAT

		o	

330 Ft. from N. Line

_____ Ft. from S. Line

_____ Ft. from E. Line

320 Ft. from W. Line

COMPLETED

Location _____

Rig up _____

Drilling and Remarks:

Sil 3529

Potential

1530

RECORD

Cased _____ in., _____ ft.

Sand _____

Gas _____

Oil _____

Total Depth 3560

PRODUCTION

1st 24 hrs. Nat. _____

1st 24 hrs. after shot _____

Gas _____ Cu. Ft.

Dry Hole _____

Abandoned _____

Date

MAR 31 1937/19

S. J. LEWIS Scout