Form 51—5M—3-35—Mid-West


Stafford

KANSAS

Map No. 2 B Sec. 31 Twp. 22 R. 11 W

Well No. 2 B Hegen Farm

Standolind Oil & Gas Company

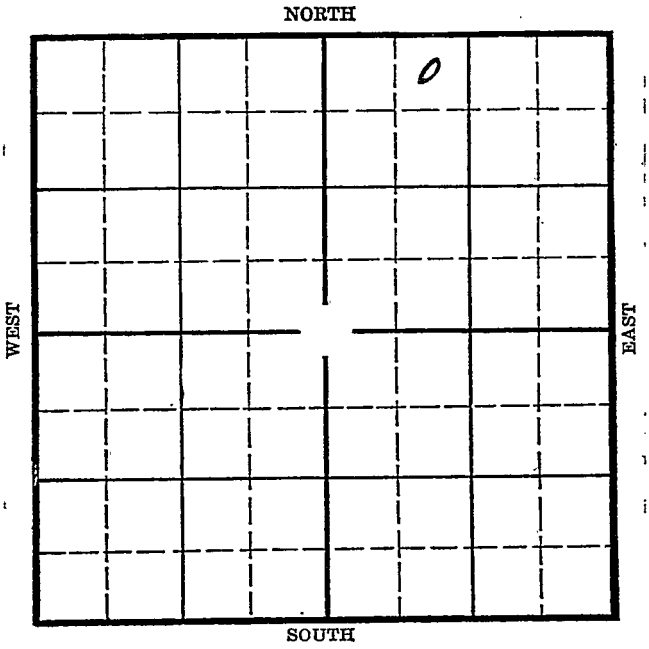

Location

Drilling Remarks

Rig Up

Drilling Remarks

RECORD

Cased ____ in. ____ ft.

Sand

Gas

Oil

Total Depth

PRODUCTION

1st 24 hrs. Nat.

1st 24 hrs. after shot

Gas ____ cu. ft.

Dry Hole

Abandoned

Form 252-A
5M 7-34 MPC

Stafford

Map No. KANSAS Sec. 31 Twp. 22 R. 11W

Well No. 2-B Heyen Farm


Stanolind Oil & Gas Company

330 Ft. from N. Line

_____ Ft. from S. Line

_____ Ft. from E. Line

990 Ft. from W. Line

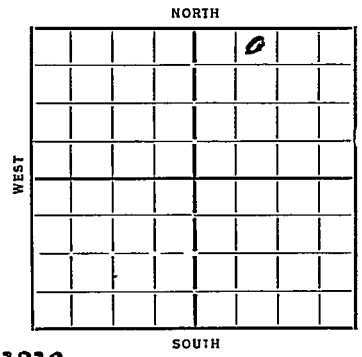

Elev. 1816

Date 1935	REPORT
11/6	Moving Rig
11/7	Rig
11/21	Dlg 1390 12½" @ 191
11/29	" 2940
12/6	Top Dr 3239
	Top Lil 3529
	TD 3535 7" 3529 Ruck
12/13	TD 3535 S.D.
12/18	Lil 3529
	TD 3535
	1139 Hole.
	COMPLETED

Form 26—1M Blk 4926

Stafford KANSAS

Map No. 46 Sec. 31 Twp. 22 R. 11W

Well No. 2B-Heyen

Standolind O+G Company

Contractor

FIRST REPORTS


330 Ft. from N. Line

Ft. from S. Line

Ft. from E. Line

990 Ft. from W. Line

SECTION PLAT

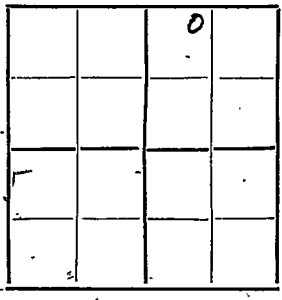

Location

Rig up

Drilling and Remarks:

Moving in

RECORD

Cased ..... in., ... ft.

Sand

Gas

Oil

Total Depth

PRODUCTION

1st 24 hrs. Nat.

1st 24 hrs. after shot

Gas ..... Cu. Ft.

Dry Hole

Abandoned

Date

10-6-35 192

ORVAL MANNSCHRECK Scout

Form 26—1M Bks. 9-28

Stafford KANSAS

Map No. 46 Sec. 31 Twp. 22 R. 11W

Well No. 2-B- Heyen

Standolind O+G Company

Contractor

COMPLETE


330 Ft. from N. Line

Ft. from S. Line

Ft. from E. Line

990 Ft. from W. Line

SECTION PLAT

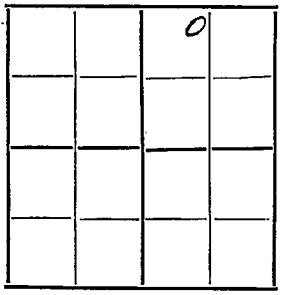

Location

Rig up

Drilling and Remarks:

1139 Lbs

RECORD

Cased in. ft.

Sand Sd 3529

Gas

Oil

Total Depth 3535

PRODUCTION

1st 24 hrs. Nat.

1st 24 hrs. after shot

Gas Cu. Ft.

Dry Hole

Abandoned

Date

12-18-35 192

Scout