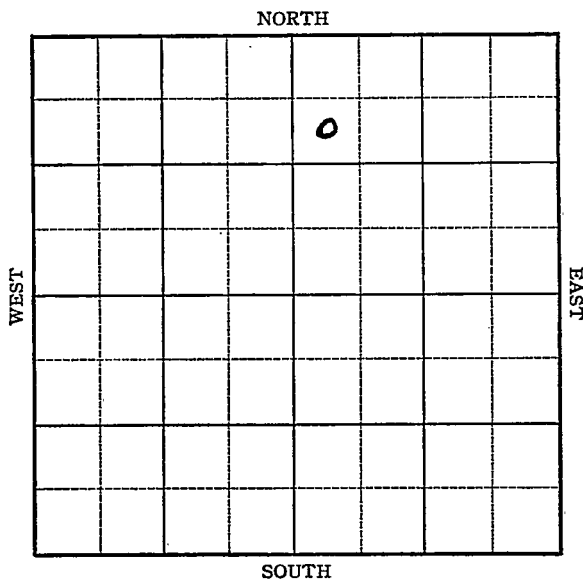


Stafford

KANSAS

Section 31 Township 22 Range 11-WWell No. #10 Heyen "B" (*Heyen*)Company Stanolind et al

Sec. 31 Twp. 22 R. 11-W

Well No. #10 Heyen "B" Farm

Stanolind et al Company


990 Ft. from N. Line

Ft. from S. Line

_____ Ft. from E. Line

330 Ft. from W. Line

Elev. 1816

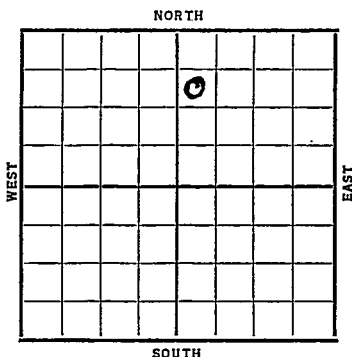

Date	REPORT
1937	
9/22	Cellar.
10/2	13" @ 247'. WOC.
10/8	Drilg. 2378'.
10/15	Sil. 3534-42' T.D. Rng. 7".
	No shows reported.
10/22	7" @ 3532'. T.D. 3542'. RUST.
10/29	T.D. 3542'. 3000' oil 1 hour.
	Swab 90 bbls. oil P.H. 900'
	off bottom.
11/3	7" @ 3532'.
	Sil. 3534'.
	T.D. 3542'.
	Potential 1965 bbls. Nat.
	COMPLETED

KANSAS

Map No. _____ Sec. 31 Twp. 22 R. 11WWell No. 10 Heyen "B"Stanolind et al. Company

Contractor _____

FIRST REPORT

SECTION PLAT

990 Ft. from N. Line

_____ Ft. from S. Line

_____ Ft. from E. Line

330 Ft. from W. Line

		0	

Location _____

Rig up _____

Drilling and Remarks:

Cellar

RECORD

Cased _____ in., _____ ft.

Sand _____

Gas _____

Oil _____

Total Depth _____

PRODUCTION

1st 24 hrs. Nat. _____

1st 24 hrs. after shot _____

Gas _____ Cu. Ft.

Dry Hole _____

Abandoned _____

Date

SEP 22 1937

19

H. D. Hatfield

Scout

Stafford **KANSAS**Map No. _____ Sec. 31 Twp. 22 R11WWell No. 10 Heyen "B"Stanolind Oil Company_____
Contractor**COMPLETED**
SW NW NE990 Ft. from N. Line

____ Ft. from S. Line

____ Ft. from E. Line

330 Ft. from W. Line**SECTION PLAT**

		0	

Location _____

Rig up _____

Drilling and Remarks:

ROT-1965
NAT

RECORDCased 7 in., 3532 ft.Sand 511 3534

Gas _____

Oil _____

Total Depth 3542**PRODUCTION**

1st 24 hrs. Nat. _____

1st 24 hrs. after shot _____

Gas _____ Cu. Ft.

Dry Hole _____

Abandoned _____

Date

NOV 3 1937 19H. D. Hatfield Scout