


Map No. **KANSAS** Sec. 31 Twp. 22 R. 3W
 Well No. 1 Corp Farm
Harris-Hain & Phillips Company

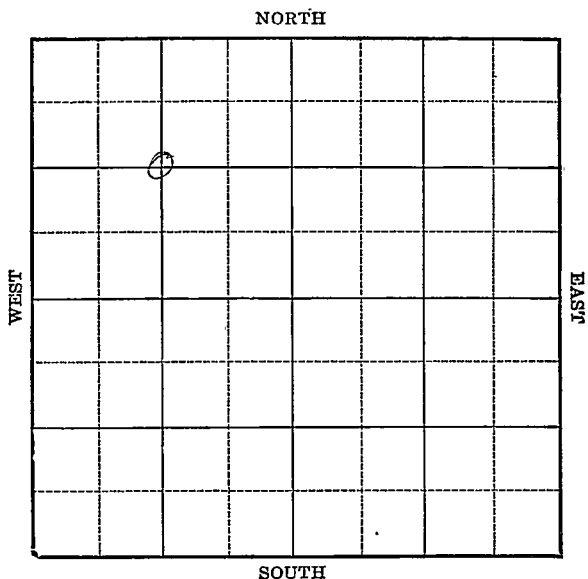

Location _____
 Drilling Remarks _____

Rig Up _____
 Drilling Remarks _____

RECORD

Cased _____ in. _____ ft.
 Sand _____
 Gas _____
 Oil _____
 Total Depth _____

PRODUCTION

1st 24 hrs. Nat. _____
 1st 24 hrs. after shot _____
 Gas _____ cu. ft.
 Dry Hole _____
 Abandoned _____

Harvey

Map No. KANSAS Sec. 31 Twp 22 R. 3W

Well No. 1- Cone Farm


Harris-Hawn-Phillips Company

1320 Ft. from N. Line

_____ Ft. from S. Line

_____ Ft. from E. Line

1320 Ft. from W. Line

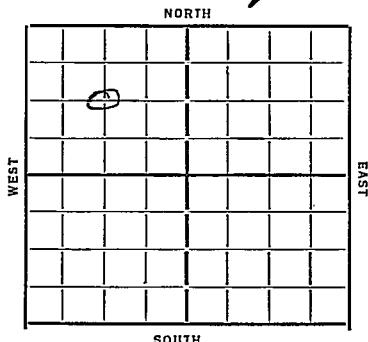

Date
1933

REPORT

9/27 moving in material
10/5 Rgn up

10/11 Spudding

10/18 20" at 268- 15" at 588'

10/25 Relg 1250

11/1 " 1735

11/8 " 2200 12" at 1150

11/15 10' at 2470, e.o.

11/23 Relg 2840

11/29 Set 8" at 2925

12/6 Top chat 3238 6" at 3238

Shew gas 3240-42 - East 1 mil gas

T.D. 3325

12/13 1000 gallon acid

12/27 re-acidizing

1/4 —

1/11 Relg 3335

1/17 — 1/24 — 1/31 — 2/7 —

2/14 Relg 3415

2/23 " 3545 5" 3492

2/28 Chat 3238 Base Line 3540

95 3562 D & A.

ABANDONED

Harvey
 Map No. 43 Sec. 31 Twp. 22 R. 3W

Well No. 1 - cone

Harris Hunt Phillips Company

Contractor


SECTION PLAT

1320 Ft. from N. Line

..... Ft. from S. Line

..... Ft. from E. Line

1320 Ft. from W. Line

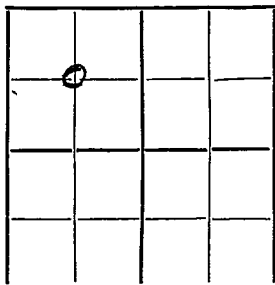

FIRST REPORTS

Location.....

Rig up.....

Drilling and Remarks: ✓

moving in

RECORD

Cased..... in., ft.

Sand.....

Gas.....

Oil.....

Total Depth.....

PRODUCTION

1st 24 hrs. Nat.....

1st 24 hrs. after shot.....

Gas..... Cu. Ft.

Dry Hole.....

Abandoned.....

Date

SEP 27 1933

P. Manschreck Scout

Map No. 43 Sec. 31 Twp. 22 R. 3W

Well No. 1- Cone

Harris, Haun & Phillips Company

Contractor


SECTION PLAT

1320 Ft. from N. Line

..... Ft. from S. Line

..... Ft. from E. Line

1320 Ft. from W. Line
ABANDONED.

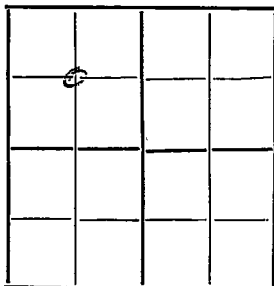

Location.....

Rig up.....

Drilling and Remarks:

Base line 3540

N & F

RECORD

Cased..... in.,..... ft.

Sand Chat 3238

Gas.....

Oil.....

Total Depth 3562

PRODUCTION

1st 24 hrs: Nat. 3

1st 24 hrs. after shot.....

Gas..... Cu. Ft.

Dry Hole.....

Abandoned.....

Date

2-28-34 192 D. Marnsch Scout