

Harvey

KANSAS

Section 31 Township 22 Range 3W

Well No. #1 Schmidt

Company Lindsey Drlg. Company

NORTH

WEST

EAST

SOUTH

Harvey

KANSAS ✓

31

22

3 W

Sec. _____ Twp. _____ R. _____

1 Schmidt

Well No. _____ Farm _____

Lindsey Drlg.

Company _____

~~Hollow-Nickie Pool~~

Contractor _____

Ft. from N. Line

990


Ft. from S. Line

330

Ft. from E. Line

Ft. from W. Line

NE SE SW

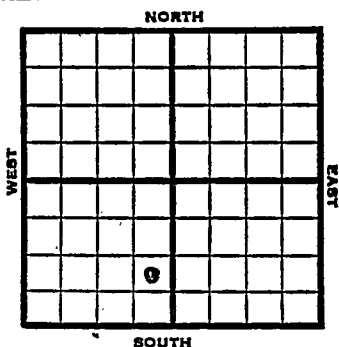

1953

Elev. 1448'

REPORT

3/25

Spud 3-13-53

8" @ 300 Miss chat 3235' Miss
dol. 3265'DST 3264-3342' open 1 hr. TD 3366'
Running casing.

4/2

5" @ 3336

CO 3366

 $\frac{1}{2}$ BOPH

4/9

NR

4/16

24/ 3283-89

 $\frac{1}{2}$ Boph

4/22

Spud 3-13-53

D&A

TD 3366

8" @ 300

Miss 3235, Miss dol 3265

DST 3264-3342, opn 1 hr., rec. 125'
mud

TD 3366

5" @ 3336,

CO to 3366, $\frac{1}{2}$ boph PB 3351 B/26 gw

2 goph 250A PB 3316 24/3278-89

B/ $\frac{1}{2}$ bw 2 $\frac{1}{2}$ goph 125,000 gas,

CO to 3285 dry

19/3279-85, 1000A, FU 2935' fluid
mostly wtr. B/17 gw SSO 12 hrs.

PB 3275, 28/3263-71, dry, 1000A

SSG, B/14 gwph 18 hr.

D&A

ABANDONED

County Harvey State Kansas
 Sec. 31 (Blk. 22 (Sur. 3W Map No.
 (Twp.) (Rge.)
 Operator Lindsey Drlg.
 Well No. 1 Farm Schmidt
 Elev. Location NE SE SW

990 Ft. From S Line SW
 330 Ft. From E Line Quarter

1st. Report MAR 25 1953

Completion

Remarks

Spudding Date 3-13-53

Drlg. Data

Hollow-Nickkle Pool


8" @ 300 Miss. chat 3235 Miss. dol. 3265

DST 3264-3342 open 1 hr. TD 3366

rng. csg.

J. G. McGEHEE

County Harvey State Kansas
 Sec. 31 (Blk.) 22 (Sur.) 3W Map No.
 Operator Lindsey Drlg.
 Well No. 1 Farm Schmidt
 Elev. 1448 Location NE SE SW

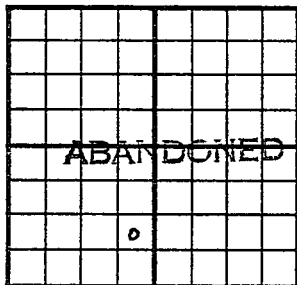

990 Ft. From S Line SW
330 Ft. From E Line Quarter

1st. Report

Completion APR 22 1953

Remarks Hollow-Nickkle Pool

Spudding Date 3-13-53

Drlg. Data D & A TD 3366
8" @ 300 Miss. 3235 Miss. dol. 3265
DST 3264-3342 open 1 hr. Rec. 125' mud
TD 3366 5" @3336 CO to 3366 $\frac{1}{2}$ boph
PB 3351 B/ 26 gw 2 goph 250 A
PB 3316 24/ 3278-89 B/ $\frac{1}{2}$ bw 2 $\frac{1}{2}$ goph
125,000 gas CO to 3285 dry
19/ 3279-85 1000 A. FU 2935' fluid
mostly wtr. B/-17 gw SSO 12 hr.
PB 3275 28/ 3263-71 dry 1000 A.
SSG B/ 14 gwph 18 hr.

D & A

J. G. MCGEHEE