


Pawnee

KANSAS

SECTION 31 TOWNSHIP 22 RANGE 17 W

WELL NO. #3 Welch "A"

COMPANY Earl Wakefield

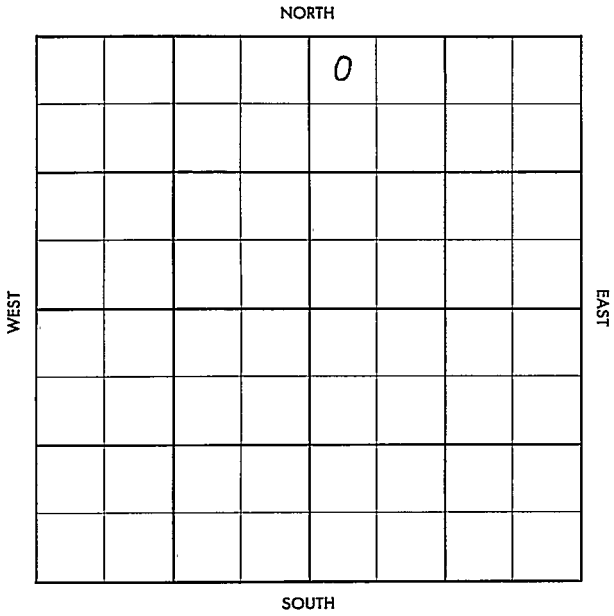

Pawnee

KANSAS

SEC. 31	TWP. 22	R.. 17W
------------	------------	------------

WELL NO.

#3 Welch "A"

FARM

COMPANY

Earl Wakefield

CONTRACTOR

Co. Tools

Garfield


_____ Ft. from N. Line

_____ Ft. from S. Line

_____ Ft. from E. Line

_____ Ft. from W. Line

NW NW NE

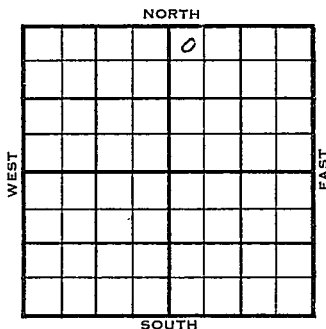

Magnolia DHM

1955	ELEVATION 2111	REPORT
------	-------------------	--------

12-7 Comm. 12-3-55
~~###~~ 8" @ 210
 Drlg. 2120

~~12-15~~

12-15 Drlg. 3794

12-21 DST 4170-4285 op $\frac{1}{2}$ hr. rec. 30' mud,
 500#
 D & A
 H. 3669
 BL. 3769
 L. 3779
 Cherty 4255
 V. 4374
 V. Chert 4378
 TD 4400'

ABANDONED

County Pawnee Elev. _____
 Sec. 31 Twp. 22 Rge. 17W
 Company Earl Warefield
 Farm Name Welch "A" No. 3

Co.

TOPS	DEPTH	LOG	DATUM
Anh.			
Tp.			
H.			
Tr.			
Dg.			
Bl.			
L.			
K.C.			
B.K.C.			
Ce.			
C.			
M.			
M.			
K.			
Mz.			
Mo.			
V.			
S.			
S.			
A.			
R.			
Pc.			
G.			
T.D.			

Loc. in Sec. NW NW NE
 Geol. _____
 Contr. _____
 Co. tools _____
 Pool Garfield
 FIRST REPORT
 DEC 7 '55

Use.

No.

Sec.

T.

R.

Date Comm. 12-3-55 Magnolia - DHM
8" @ 210 drlg. 2120

[Handwritten signature and scribbles]

County Pawnee Elev. 2111
 Sec. 31 Twp. 22 Rge. 17W
 Company Earl Wakefield
 FarmName Welch "A" No. 3

TOPS	DEPTH	LOG	DATUM	Loc. in Sec.
Anh.				NW NW NE
Ip.				
H.	3669		1559	
Tr.				
Dg.				
Bl.	3769		1658	
L.	3779		1668	
K.C.				Geol.
B.K.C.				Contr.
Ce.				
C. cherty	4255		2144	Co. tools
M.				
M.				Pool
K.				Garfield
Mz.				
Ma.				
V.	4374		2263	
S. chert	4378		2267	
S.				
A.				
R.				
Pe.				ABANDONED
G.				
T.D.	4400			

Date Comm. 12-3-55 DEC 3 1 1955

8" @ 210 DST 4170-4285 open $\frac{1}{2}$ hr.

rec. 30' mud 500#

D & A