


Section 31 Township 22 Range 17 W

Well No. #2 Welsh "A"

Company E. F. Wakefield

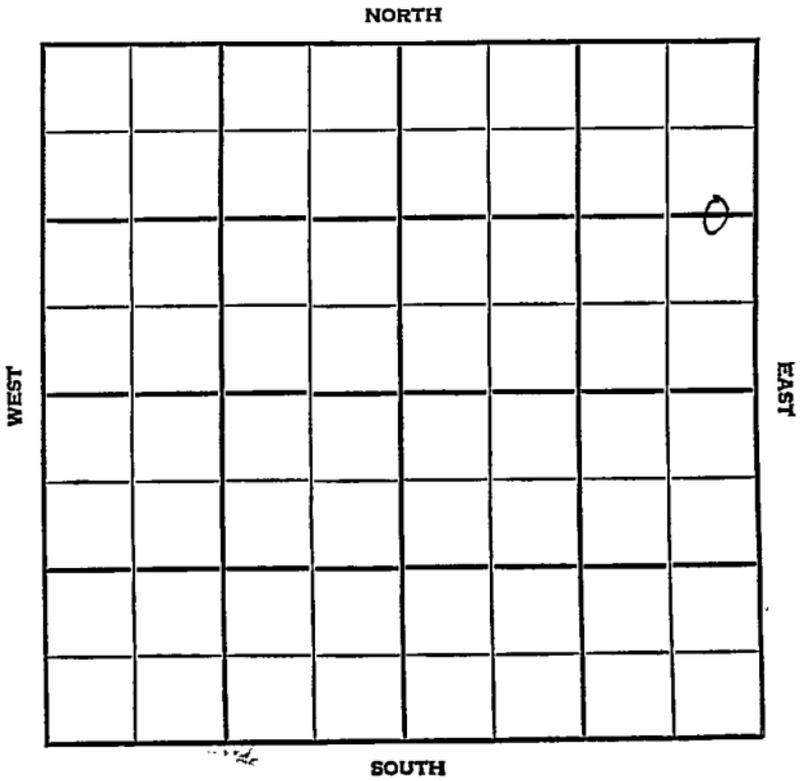

SEC.	TWP.	R.
31	22	17W

WELL NO.

#2 Welsh "A"

FARM

COMPANY

E. F. Wakefield

CONTRACTOR


Co. Tools
Garfield

_____ Ft. from N. Line

_____ Ft. from S. Line

_____ Ft. from E. Line

_____ Ft. from W. Line

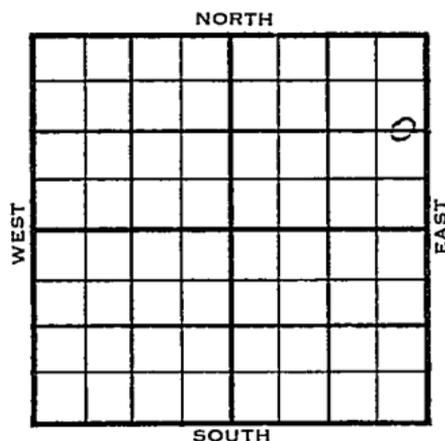E $\frac{1}{2}$ E $\frac{1}{2}$ NE

1955

ELEVATION

2100'

REPORT

7/27

Comm 7-22-55
Ft. Riley 2285
8" @ 200/210
Drlg 2454

9-21

DST 4170-4200 op 30" gas 3" ga.
2,930,000 cfg., rec. 90' ho & gcm
BHP 1382# 20";
5 $\frac{1}{2}$ " @ 4289;
CO 4275; 6/4239-40; 16/4242-45;
Phy. flo 52 bopd no wtr.
Tops: H. 3649
B.L. 3750
Lansing 3759
Sh 4175
Ch. Cong 4196
Mz. 4240
V. 4274
T.D. 4290'

COMPLETED

County Pawnee Elev. _____
 Sec. 31 Twp. 22 Rge. 17W
 Company E. F. Wakefield
 Farm Name Welsh "A" No. 2

TOPS	DEPTH	LOG	DATUM
------	-------	-----	-------

Loc. in Sec. E $\frac{1}{2}$ E $\frac{1}{2}$ NE

Anh.			
Tr.			
H.			
Tr.			
Dg.			
BL.			
L. <u>St Riley</u>	<u>2285</u>		
K.C.			
B.K.C.			
Ce.			
C.			
M.			
M.			
K.			
Mz.			
Ma.			
V.			
S.			
S.			
A.			
R.			
PE.			
G.			
T.D.			

Geol. _____
 Contr. _____

Co. tools

Pool

Garfield

FIRST REPORT

JUL 27 '55

Date Comm. 7-22-55

8" @ 200/210 drlg. 2454

[Handwritten signature]

Co.

Lse.

No.


Sec.

T.

R.

County Pawnee Elev. 2100
 Sec. 31 Twp. 22S Rge. 17W
 Company E. F. Wakefield
 Farm Name Welsh "A" No. 2

TOPS	DEPTH	LOG	DATUM	Loc. in Sec.
Anh.				$E\frac{1}{2}$ $E\frac{1}{2}$ NE
TP.				
H.	3649		1549	
Tr.				
Dg.				
Bl.	3750		1650	
L. <u>Ft Riley</u>	4285		185	
K. <u>Lansing</u>	3759		1659	Geol.
B.K.C.				Contr.
Ce.				<u>Co. tools</u>
C. <u>Sh</u>	4175		2075	
M. <u>Ch. Cong</u>	4196		2096	Pool
M.				<u>Garfield</u>
K.	4240		2140	
Mz.				
Me.	4274		2174	
V.				
S.				
S.				
A.				
R.				
Pe.				
G.				
TD.	4294			

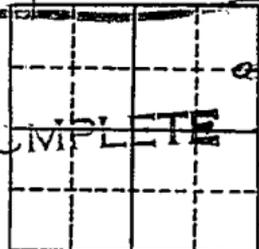

Date Comm. 7-22-55 SEP 21 1955

8" 200 w/210; DST 4170-4200 op 30" gas
 3" ga. 2,930,000 cfg, rec. 90' ho and gem
 BHP 1382# 20"; 5 $\frac{1}{2}$ " 4289; CO 4275; 6/4239-
 40; 16/4242-45; Phy. flo 52 bopd no wtr.