


Section 31 Township 22 Range 19W

Well No. #1 Kuefeld

Company Gabbert-Jones

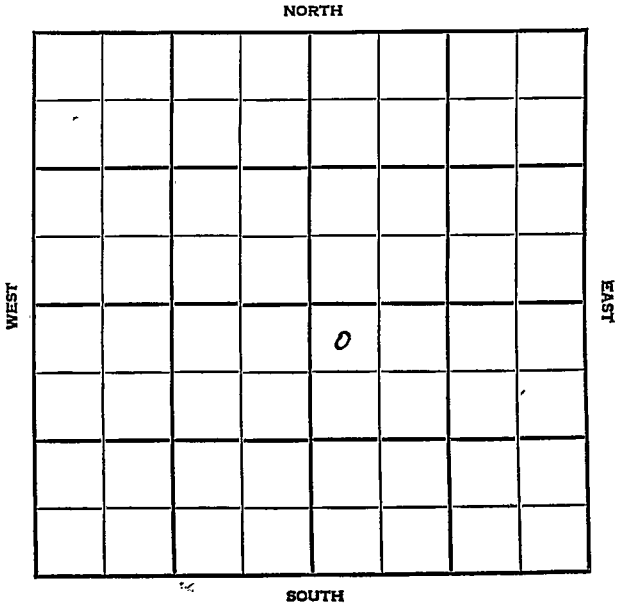

Pawnee

KANSAS

SEC.

TWP.

R.

31

22

19 W

WELL NO.

# 1 Kuefeld

FARM

COMPANY

Gabbert-Jones

CONTRACTOR

Wildcat


\_\_\_\_\_ Ft. from N. Line

\_\_\_\_\_ Ft. from S. Line

\_\_\_\_\_ Ft. from E. Line

\_\_\_\_\_ Ft. from W. Line

NW NW SE

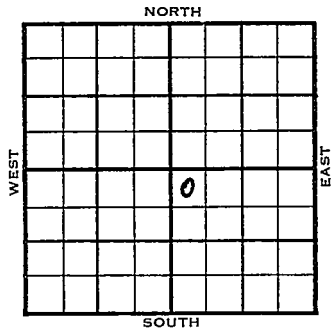

ELEVATION

1955

2215' DF 2212' GF <sup>REPORT</sup>

6/8

Comm. 5-13-55

8" @ 226

DST 4572-87 open 1 1/2 hr rec 160' muddy SW, 1280/30"

D & A

TOPS: H. 3825', L. 3932', M. 4483'

K. 4570', V. 4665', S. 4820',

A. 4881'

LOG: H. 3829' L. 3928, M. 4484',

V. 4666', S. 4820' A. 4881'

TD 4909' Schl TD 4906'

D & A

FIRST REPORT

~~ABANDONED~~

County Pawnee Elev. 2215 DF  
2212 GF  
 Sec. 31 Twp. 22 Rgs. 19W  
 Company Gabbert-Jones  
 Farm Name Kuefeld No. 1

TOPS	DEPTH	LOG	DATUM
Anh.			
TP.			
H.	3825	3829	1617
Tr.			
Dg.			
Bl.			
L.	3932	3928	1716
K.C.			
B.K.C.			
Ce.			
C.			
M.	4483	4484	2272
M.			
K.	4570		2258
Mz.			
Me.			
V.	4665	4666	2454
S.	4820	4820	2608
S.			
A.	4881	4881	2669
R.			
PE.			
G.			
TD.	4909	4906	

Loc. in Sec. \_\_\_\_\_  
 NW NW SE  
 Geol. \_\_\_\_\_  
 Contr. \_\_\_\_\_  
 Pool \_\_\_\_\_  
 Wildcat



Date Comm. 5-13-55 JUN 8 1955

8" @ 226 DST 4572-87 open 1 1/2 hr.

Rec. 160' muddy sw 1280/30"

D & A

\_\_\_\_\_  
 \_\_\_\_\_  
 \_\_\_\_\_  
 \_\_\_\_\_  
 \_\_\_\_\_  
 \_\_\_\_\_

Co.  
 Lse.  
 No.  
 Sec.  
 T.  
 R.