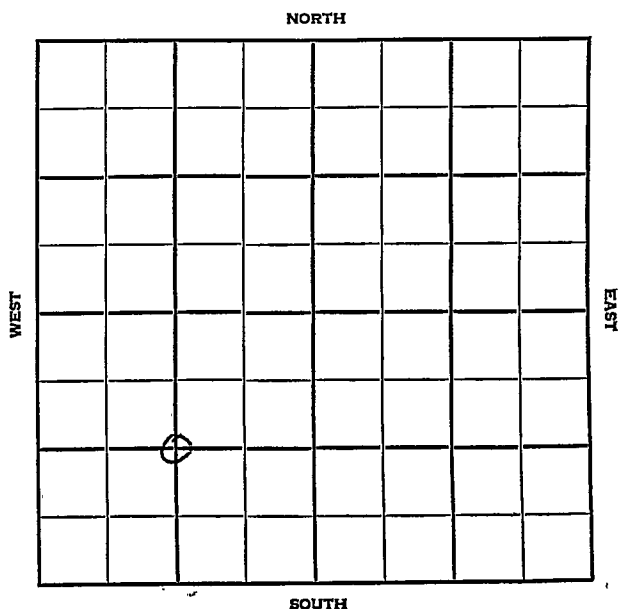


Section 31 Township 22 Range 32 WWell No. #1 Hobart "A"Company Northern Natural

Finney

KANSAS

SEC.	TWP.	R.
31	22	32W

WELL NO.

#1 Hobart "A"

FARM

COMPANY

Northern Natural

CONTRACTOR

Michaelis

Hugoton


Ft. from N. Line

Ft. from S. Line

Ft. from E. Line

Ft. from W. Line

C SW/4

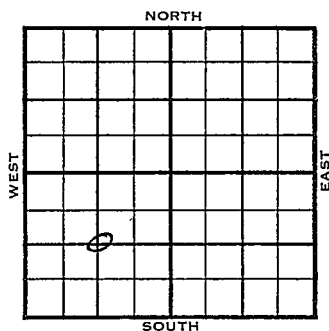

1956

ELEVATION

REPORT

2857 DF, 2855 GF

2-22

8" @ 403 w/325
Drlg. 2550

3-14

5½" @ 2601/700
 CO to 2615, 4,295 mcfg, 36/2501-10
 90/ 2526-36, 80/ 2542-62
 PB 2595, 5000 A, frac, 7,600 mcfg,
 300 A
 Comp. ### 17,300 mcfgpd, 426#
 Herr. 2500
 L. Kri 2540
 Winf. 2596
 TD 2615'

COMPLETED

County Finney Elev. 2855 Gr.
 Sec. 31 Twp. 22 Rge. 32W
 Company Northern Natural
 Farm Name Hobart "A" No. 1

TOPS	DEPTH	LOG	DATUM	Loc. in Sec.
Anh.				<u>C SW/4</u>
TP.				
H.				
Tr.				
Dg.				
BL.				
L.				Geol.
K.C.				Contr.
B.K.C.				<u>Michaelis</u>
Ce.				Pool
C.				<u>Hugoton</u>
M.				
M.				
K.				
Mz.				
Me.				
V.				
S.				
S.				
A.				
R.				
PE.				
G.				
T.D.				

FIRST REPORT

FEB 22 '56

Date Comm.

8" @ 403 /325 drlg. 2550

31
35

2857 DF

2855 GF

County Finney

Elev.

Sec. 31

Twp.

22

Rge.

32W

Company

Northern Natural

FarmName

Hobart "A"No. 1

TOPS

DEPTH

LOG

DATUM

Loc. in Sec.

Anh.

T.P. Wesr.C SW/4H. W. K. R.Tr. W. K. R.

Dg.

BL.

L.

K.C.

B.K.C.

Cc.

C.

M.

M.

K.

Mz.

Mq.

V.

S.

S.

A.

R.

Pc.

G.

T.D.

Geol.

Contr.

Michaelis

Pool

Hugoton

COMPLETE

Date Comm.

MAR 14 1956

8" @ 403/325 5 $\frac{1}{2}$ " @ 2601/700

CO to 2615 4,295 mcfg 36/ 2501-10

90/ 2526-36 80/ 2542-62 PB 2595

5000 A frac 7,600 mcfg 300 A

Comp. 17,300 mcfgpd 426#