

KANSAS


Finney

Section 31 Township 22 Range 34W

Well No. 1 Foster

Company Warren Pet.

Hugoton
NORTH

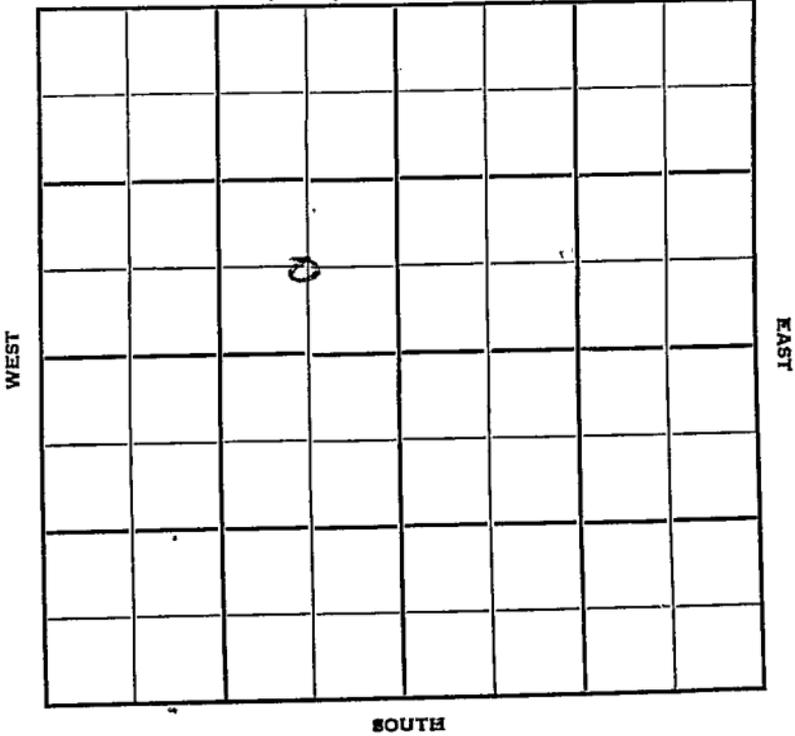

Sec. 31 Twp. 22 R. 34W

Well No. 1 Foster Farm

Warren Pet. Company


Hugoton Pool

 Ft. from N. Line

660 Ft. from S. Line

660 Ft. from E. Line

 Ft. from W. Line

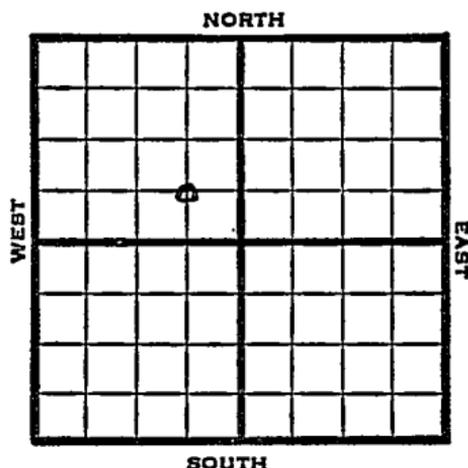

C SE NW

1949

Elev. 2996' REPORT

9/28

Location

10/5

10" @ 305'

Drlg 2100'

10/12

TD 2500'

7" @ 2496'

10/19

"

10/26

"

11/1

100 qts 2515-50

TD 2670'

Acid 15000

177' of 5" Perf liner @ 2670'

11/9

"

11/16

TD 2670'

7" @ 2496'

177' of 5" Perf Liner @ 2670'

15000 acid

10,860,000 Gas

410# R Pr.

Comp

COMPLETED

Map No. _____ Sec. 31 Twp. 32 R. 34W

Well No. 1 Foster

Warren Pet. Company

Burris Drlg. Contractor

C SE NW

FIRST REPORT
SECTION PLAT

	o		

_____ Ft. from N. Line

660 Ft. from S. Line

660 Ft. from E. Line

_____ Ft. from W. Line

Finney County

Location X

RECORD

Cased _____ in., _____ ft.

Rig up _____ Sand _____

Drilling and Remarks: _____ Gas _____

Oil _____

Total Depth _____

PRODUCTION

1st 24 hrs. Nat. _____

1st 24 hrs. after shot _____

Gas _____ Cu. Ft.

Dry Hole _____

Abandoned _____

Date

SEP 28 1949 19

S. J. LEWIS Scout

Map No. _____ Sec. 31 Twp. 22 R. 34W


Well No. 1 Foster

Warren Pet. _____ Company

Contractor

C SE NW

SECTION PLAT

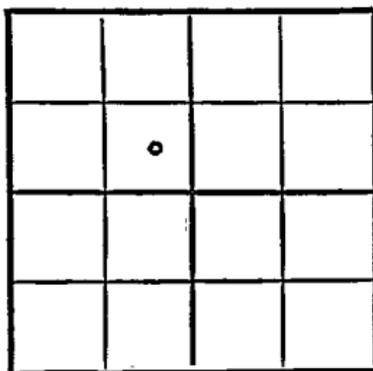

_____ Ft. from N. Line

660 Ft. from S. Line

660 Ft. from E. Line

_____ Ft. from W. Line

Finney County

RECORD

Location _____

Cased _____ in., _____ ft.

Rig up _____

Sand _____

Drilling and Remarks:

Gas _____

Oil _____

Total Depth _____

Reported

31-32-34W

PRODUCTION

1st 24 hrs. Nat. _____

1st 24 hrs. after shot _____

Gas _____ Cu. Ft.

Dry Hole _____

Abandoned _____

Date

Map No. _____ Sec. 31 Twp. 22 R. 34W

Well No. 1 Foster

Warren Pet. Company

COMPLETE

Contractor

C SE NW

E12996
SECTION PLAT

_____ Ft. from N. Line

660 Ft. from S. Line

660 Ft. from E. Line

_____ Ft. from W. Line

Finney County

Location _____

Rig up _____

Drilling and Remarks:

7" C2496
177' of 5" Perf. lines
C2670
15000 gals
10, 865,000 gal
HFD # R/fe

RECORD

Cased _____ in., _____ ft.

Sand _____

Gas _____

Oil _____

Total Depth 2670

PRODUCTION

1st 24 hrs. Nat. _____

1st 24 hrs. after shot _____

Gas _____ Cu. Ft.

Dry Hole _____

Abandoned _____

Date

NOV 16 1949

19

S. J. LEWIS

Scout