

Section 32 Township 22 Range 12WWell No. 1 HowardCompany M. B. Armer

NORTH

							0

WEST

EAST

SOUTH

Stafford

KANSAS ✓

Sec. 32 Twp. 22 R. 12W

Well No. #1 Howard Farm

M. B. Armer Company

G-M-R Oil Contractor
Wildcat


Ft. from N. Line

330 Ft. from S. Line

330 Ft. from E. Line

Ft. from W. Line

SE SE SE
CSO -DHM

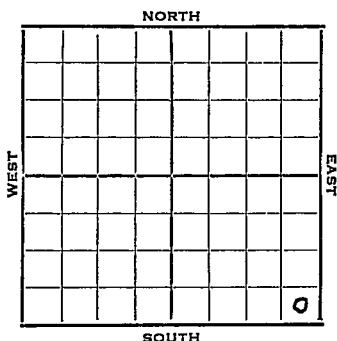

1952 Elev. 1847' REPORT

12/10 Spud 12-8-52
8" @ 254'

12/11 8" @ 254'

12/18 Heeb 3178 Br 1 3212 Lans 3333 Ø3375

12/23 Spud 12-8-52

D & A TD 3750' 8" @ 254'

Heeb 3178' Br. lime 3312' Lans 3333'

DST 3366-81 open 1/2 hr. rec 540' GCM
1320#

DST 3493-3500 open 3/4 hr. rec 30' mud
745#

DST 3504-29 open 1 hr. rec 35' OCM,
40' mud 105#

DST 3648-81 open 1 hr. rec 90' WCM

768# Cong. 3598' Viola 3616'

Simp. 3684' Arb. 3740'


DST 3742-50 open 1 hr. rec 80' sul wtr.

1175# TD 3750' D & A

ABANDONED

J. G. McGEHEE

County Stafford State Kansas
 Sec. 32 (Blk.) 22 (Sur.) 12W Map No.
 Operator M. B. Armer
 Well No. 1 Farm Howard
 Elev. 1847 Location SE SE SE

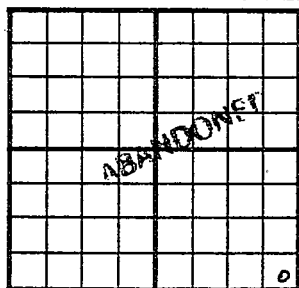

330 Ft. From S Line SE
330 Ft. From E Line Quarter
 Ist. Report
 Completion DEC 23 1952
 Remarks Wildcat
G-M-R Oil - Contr.
 Spudding Date 12-8-52

Drig. Data D & A TD 3750
8" @ 254 Heeb. 3178 Br. lime 3312
Lans. 3333 DST 3366-81 open $\frac{1}{2}$ hr.
Rec. 540' gcm 1320# DST 3493-3500
open $\frac{3}{4}$ hr. Rec. 30' mud 745#
DST 3504-29 open 1 hr. Rec. 35' ocm
40' mud 105# DST 3648-81 open 1 hr.
Rec. 90' wcm 768# Cong. 3598 Viola
3616 Simp. 3684 Arb. 3740 DST 3742-50
open 1 hr. Rec. 80' sul. wtr. 1175#
 TD 3750

D & A

J. G. McGEHEE