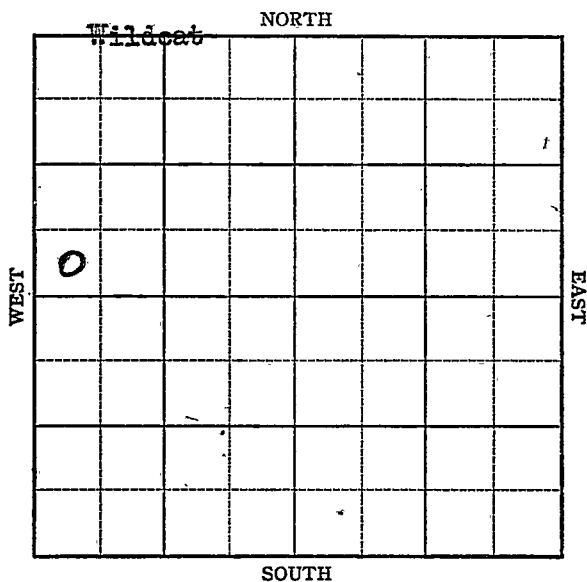


KANSAS

Stafford

FORM 51 IOM 12-46 PETROL

Section 32 Township 22 Range 13NWell No. 1 RuscoCompany Virginia Drlg.

KANSAS

Stafford County

Sec. 32 Twp. 22 R. 13-W

Well No. 1 Rusco Farm

Virginia Drlg. Company

Wildcat


Ft. from N. Line

330 Ft. from S. Line

Ft. from E. Line

330 Ft. from W. Line

SW NW

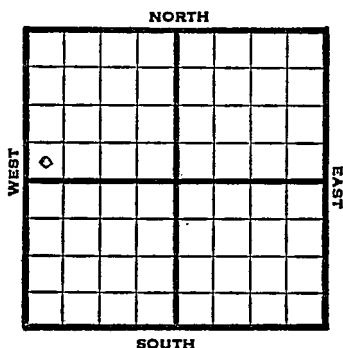

1947	Elev.	REPORT	1920'
7/30	Loc.		
8/6	RUR		
8/13	8" @ 313'		
	Drlg. 2690'		
8/20	Lansing 3502'		
	Viola 3858'		
	Arbuckle 3964'		
	Drlg 3985'		
8/27	Lansing 3502'		
	Arbuckle 3964'		
	Total Depth 3996'		
	ABANDONED		

Kansas

Map No. _____ Sec. 32 Twp. 22 R. 13WWell No. 1 Rusco_____Virginia Drllg._____Company_____~~FIRST REPORT~~_____Contractor

SW NW

SECTION PLAT

_____Ft. from N. Line_____330 Ft. from S. Line_____Ft. from E. Line_____330 Ft. from W. Line_____Stafford CountyLocation X

Rig up _____

Drilling and Remarks:

RECORD

Cased _____ in., _____ ft.

Sand _____

Gas _____

Oil _____

Total Depth _____

PRODUCTION

1st 24 hrs. Nat. _____

1st 24 hrs. after shot _____

Gas _____ Cu. Ft.

Dry Hole _____

Abandoned _____

Date

JUL 30 1947 19 _____ S. J. LEWIS Scout

Map No. 82 Sec. 32 Twp. 22 R. 13W

Well No. 1 Rusco

Virginia Drlg. Company

ABANDONED

Contractor

SW NW


E. 11920
SECTION PLAT

 Ft. from N. Line

330 Ft. from S. Line

 Ft. from E. Line

330 Ft. from W. Line

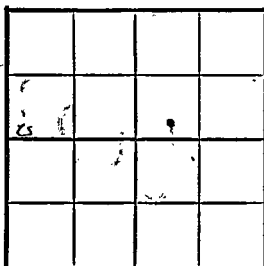

Stafford County

Location

Rig up

Drilling and Remarks:

Lane 3302

CE 8964

RECORD

Cased in. ft.

Sand

Gas

Oil

Total Depth 8996

PRODUCTION

1st 24 hrs. Nat.

1st 24 hrs. after shot

Gas Cu. Ft.

Dry Hole

Abandoned

Date

AUG 27 1947 19 S. J. LEWIS Scout