


Section 32 Township 22 Range 13WWell No. #1 MiltonCompany Palmer Oil

KANSAS

Stafford

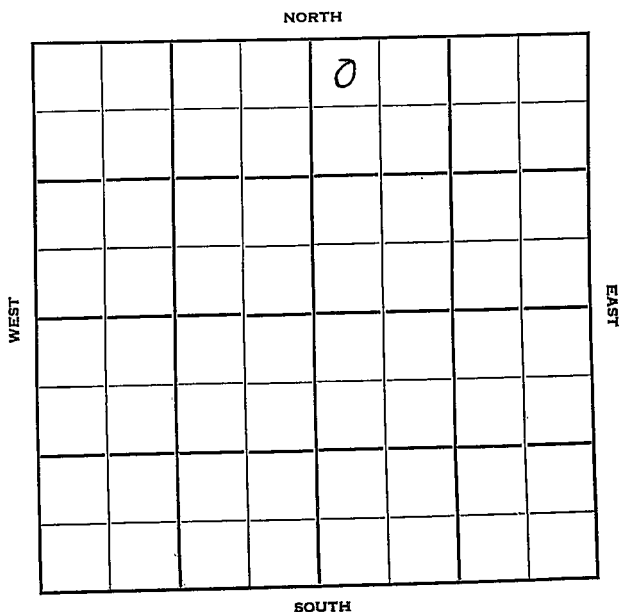

Sec. 32 Twp. 22 R. 13-W

Well No. #1 Milton Farm

Palmer Oil

Company

Contractor

Wildcat


330 Ft. from N. Line

Ft. from S. Line

Ft. from E. Line

330 Ft. from W. Line

NW NW NE

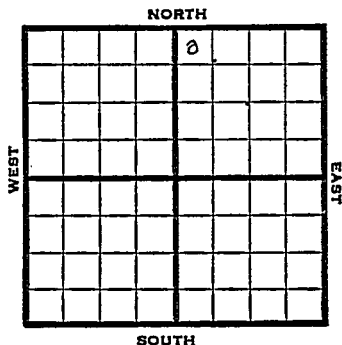

1950

Elev 1917'

REPORT

2/1

Spud 1-27-50
8 5/8" @ 330'
Anhy 789-803
Drlg 1358'

2/15

TD 3887'
8 5/8" @ 330'
Lans 3458'
Viola 3754'
Simp 3804'
Arb. 3881'
D&A
Aband.

ABANDONED

Map No. _____ Sec. 32 Twp. 22 R. 13WWell No. 1 Milton

_____ Palmer Oil _____ Company

_____ Contractor

NW NW NE


E1. 1917

SECTION PLAT

330 Ft. from N. Line

_____ Ft. from S. Line

_____ Ft. from E. Line

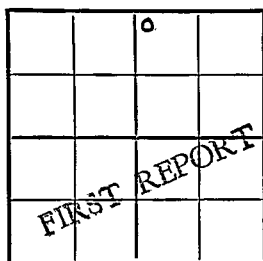330 Ft. from W. Line

Stafford County

Location _____

Rig up _____

Drilling and Remarks:

Spud 1-27-50

8 5/8" @ 330

Anhy 789-803

drlg. 1358

RECORD

Cased _____ in., _____ ft.

Sand _____

Gas _____

Oil _____

Total Depth _____

PRODUCTION

1st 24 hrs. Nat. _____

1st 24 hrs. after shot _____

Gas _____ Cu. Ft.

Dry Hole _____

Abandoned _____

Date

r t B 1 1950 19 J. E. TYRA Scout

Map No. _____ Sec. 32 Twp. 22 R. 13W

Well No. 1 Milton

Palmer Oil Company

Contractor

NW NW NE


El. 1917
SECTION PLAT

330 Ft. from N. Line

_____ Ft. from S. Line

_____ Ft. from E. Line

330 Ft. from W. Line

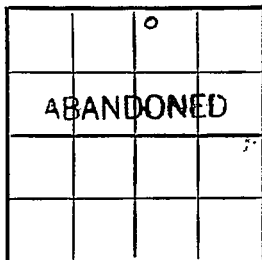

Stafford County

Location _____

Rig up _____

Drilling and Remarks:

8 5/8" @ 330
Lans 3458
Viola 3754
Simp 3864
amb 3881
D & A

RECORD

Cased _____ in., _____ ft.

Sand _____

Gas _____

Oil _____

Total Depth 3887

PRODUCTION

1st 24 hrs. Nat. _____

1st 24 hrs. after shot _____

Gas _____ Cu. Ft.

Dry Hole _____

Abandoned _____

Date

FEB 15 1950

J. E. TYRA

19

Scout