

Stafford


KANSAS

SECTION 32 TOWNSHIP 22 RANGE 14 W

WELL NO. #1 McAllister

COMPANY Lauck & Sunray Mid-Continent

NORTH

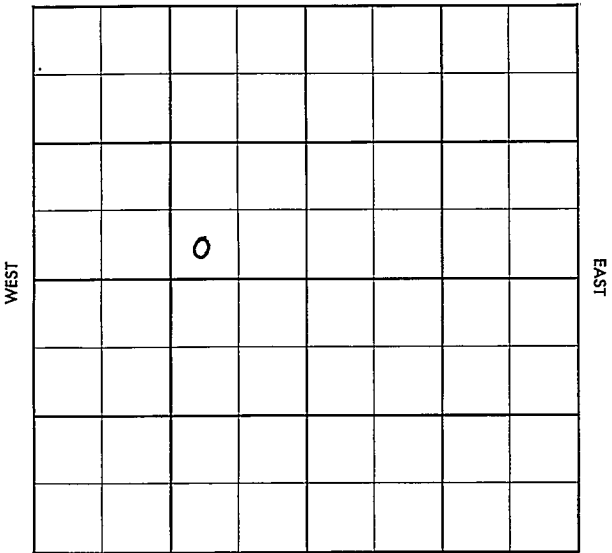

SOUTH

# HOT FILE Stafford KANSAS

SEC. 32 TWP. 22 S R. 11 W

WELL NO. #1 McAllister FARM

COMPANY D.R. Lauck Oil Co. Inc. & SDX

CONTRACTOR Lauck Oil

**Wildcat**

\_\_\_\_\_ Ft. from N. Line

\_\_\_\_\_ Ft. from S. Line

\_\_\_\_\_ Ft. from E. Line

\_\_\_\_\_ Ft. from W. Line

SW SE NW

SDX BH \$7,000.00

Lse. (S-28681)

NORTH

		0			

SOUTH

WEST EAST

CSO - AC

ELEVATION 1965' RB 1963 DF REPORT (WH5-BH28)

1/24	Arbuckle test well @ 1100' To be commenced by Feb. 8, 1956 To be completed by Feb. 29, 1956 (See Acr. Cont. & Drlg. Agr. 1-20-56)
1/25	Spudded 1-22-56 Set 8-5/8" @ 222'. <span style="float: right;">(F.R.Tkt)</span> Drlg. 1500' <span style="float: right;">(Card-D.R.Lauck Oil)</span>
1/26	Drlg. 2425' BKC 3771 - 3772
1/27	Drlg. 2900' V. Chert 3886-3895
1/28	Drlg. 3275' S.Sh. 3949-3981
1/29	Drlg. 3535' Anhy. 855 "
1/30	Drlg. 3670' Viola 3886 "
1/31	T. Heebner 3394' (-1429) T. Brown Lime 3527 (-1562) T. Lansing 3537' (-1572) Drlg. 3800' A. 4030-4040 "
2/5	Rig was broken down for 3 days. Drlg. 4000' "
2/6	Drlg. 4057'. TD 4057'. <u>D &amp; A.</u> "
2/9	Advised Contract Section-D & A
2/16	Received copies of Driller's Log & Halliburton Elec. Survey Radiation Log - Given to S.A. Shannon-Div. Geol.

ABANDONED

County Stafford Elev. \_\_\_\_\_  
 Sec. 32 Twp. (21) Rge. 11W  
 Company Lauck & Sunray Mid-Continent  
 Farm Name McAllister No. 1

TOPS	DEPTH	LOG	DATUM	Loc. in Sec.
Anb.				SW SE NW
Tr.				
H.				
Tr.				
Dg.				Geol. _____
Bl.				
L.				Contr. _____
K.C.				
B.K.C.				Lauck
Ce.				
C.				Pool _____
M.				
M.				Wildcat
K.				
Mz.				<div style="border: 1px dashed black; padding: 5px; text-align: center;">                     JAN 25 '56                      10                      FIRST REPORT                 </div>
Me.				
V.				
S.				
S.				
A.				
R.				
Pe.				
G.				
T.D.				

Date Comm. 1-22-56 CSO - AC  
8" @ 222 drlg.

~~XB~~

Co.  
No.  
Sec.  
T.  
R.

County **Stafford** Elev. **1965 KB**  
 Sec. **32** Twp. **22** Rge. **14W**  
 Company **Lauck & Sunray Mid-Continent**  
 Farm Name **McAllister** No. **1**

	TOPS	DEPTH	LOG	DATUM	Loc. in Sec.
Ant.		855			SW SE NW
1		3394			
2					
3		3527	3532	1569	
4		3537	3541	1578	Geol.
5	X	3771	3772	1809	Contr.
6					<b>Lauck</b>
7					Pool
8					<b>Wildcat</b>
9					
10					
FEB 8 1956  
 a  
**ABANDONED**

Date Comm. **1-22-56** CSO - AC  
 8" @ 222 drlg. FEB 1 '56 - 3760 FEB 8 '56

*No shows Run Log  
 Log tops  
 H & A*