

Section 32 Township 22 Range 7W

Well No. #1 Moorman

Company J. H. Johnson Drlg.

NORTH

WEST

EAST

							0

SOUTH

Reno

KANSAS

Sec. 32 Twp. 22 R. 7 W

Well No. # 1 Moorman Farm

J. H. Johnson Drlg. Company

Stearns Drlg. Contractor

Wildcat

330 Ft. from N. Line


 Ft. from S. Line

330 Ft. from E. Line

 Ft. from W. Line

NE NE NE

Sun Oil - DHM & BHM

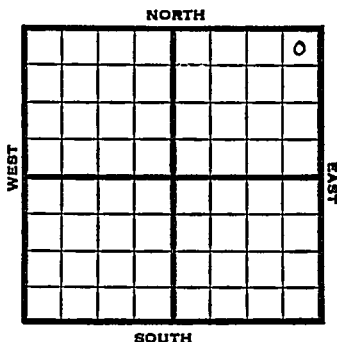

1951 Elev. 1607' REPORT

10/3 Spud 9-27-51
8" @ 193'

Drlg. 2490'

10/24 Spud 9-27-51
D&A TD 3951
8" @ 193

Lans. 2985 Miss. 3516

DST 3520-33 open 45 min.

Rec. 60' mud

Viola 3835 Simp. 3865 Arb. 3937


TD 3951 5" @ 3581

45/ 3518-24 500 A wtr.

D&A

ABANDONED

County Reno State Kansas
 Sec. 32 (Blk. Twp.) 22 (Sur. Rge.) 7W Map No. _____
 Operator J. H. Johnson drlg.
 Well No. 1 Farm Moorman
 Elev. 1607 Location NE NE NE

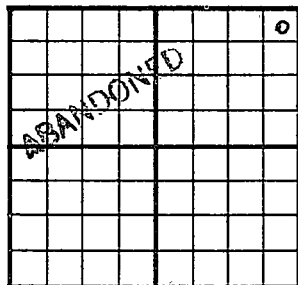

330 Ft. From N Line NE
330 Ft. From E Line Quarter

Ist. Report

Completion OCT 24 1951

Remarks Wildcat
Stearn Drlg. - Contr.

Spudding Date 9-27-51

Drlg. Data D & A TD 3951

8" @ 193 Lans. 2985 Miss. 3516

DST 3520-33 open 45 min. Rec. 60' mud

Viola 3835 Simp. 3865 Arb. 3937

TD 3951 5" @ 3581 45/ 3518-24

500 A water

D & A

J. E. TYRA