


Stafford KANSAS

Section 32 Township 22 Range 11-W

Well Number 2 Heyen "C"

Company Stanolind

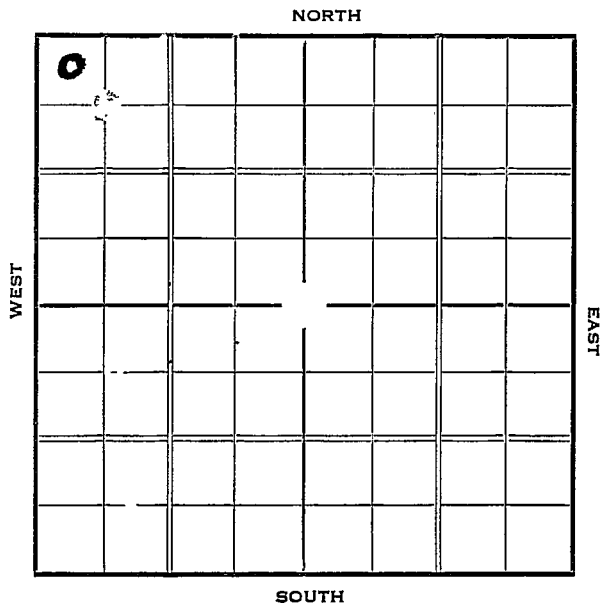

1937

6/9

6" @ 3551'.

Sil. 3551'.

T.D. 3570'.

Swab 28 oil P.H. 2 hrs.

2000 acid.

Pump 1284 bbls. 18 hrs.

Pot. 1694 bbls.

COMPLETED

KANSAS

Stacyford

Map No. _____ Sec. 32 Twp. 22 R. 11WWell No. 2 Hagen "C"Stan O'Neil Company

Contractor

SECTION PLAT

0			

330 Ft. from N. Line

_____ Ft. from S. Line

_____ Ft. from E. Line

330 Ft. from W. Line

FIRST REPORT

Location ✓

Rig up _____

Drilling and Remarks:

RECORD

Cased _____ in., _____ ft.

Sand _____

Gas _____

Oil _____

Total Depth _____

PRODUCTION

1st 24 hrs. Nat. _____

1st 24 hrs. after shot _____

Gas _____ Cu. Ft.

Dry Hole _____

Abandoned _____

Date

APR 14 1937

S. J. LEWIS

Scout

Map No. 46 Sec. 32 Twp. 22 R. 11 WWell No. 2-Heyen "C"Stanford Company

Contractor

COMPLETED

SECTION PLAT

0			

330 Ft. from N. Line

_____ Ft. from S. Line

_____ Ft. from E. Line

330 Ft. from W. Line

Location _____

Rig up _____

Drilling and Remarks:

Swb 28 oil P.H. - 2 hrs2000 APump 1284/18 hrsPat 1694

RECORD

Cased 6 in., 3551 ft.Sand Sl 3551

Gas _____

Oil _____

Total Depth 3570

PRODUCTION

1st 24 hrs. Nat. _____

1st 24 hrs. after shot _____

Gas _____ Cu. Ft.

Dry Hole _____

Abandoned _____

Date

H. D. Hatfield

JUN 9 1937 19

Scout