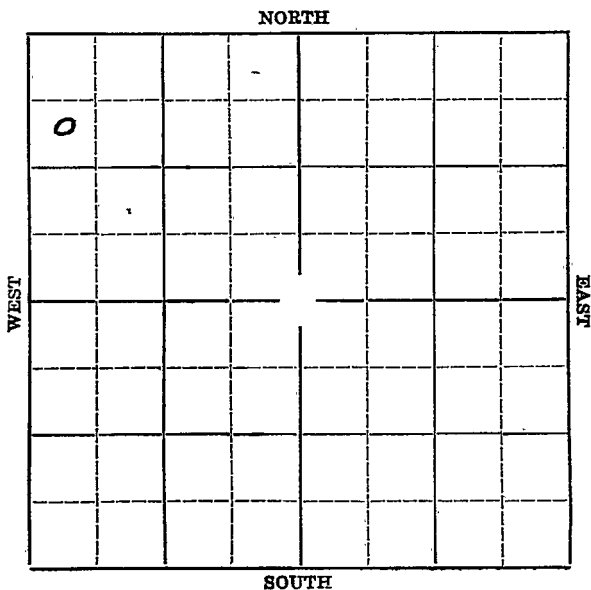


Section 32 Township 22 Range 11-WWell Number #1 H. L. Hart
*Hoyen "C"*Company Stanolind

KANSAS Stafford

Form 252-A-5M-7-36-Palace

Sec. 32 Twp. -22 R. 11W

Well No. #1 H.L. Hart #1 Hayen C Farm

Stanolind

Company


990' Ft. from N. Line

Ft. from S. Line

Ft. from E. Line

330' Ft. from W. Line

Elev. 1819

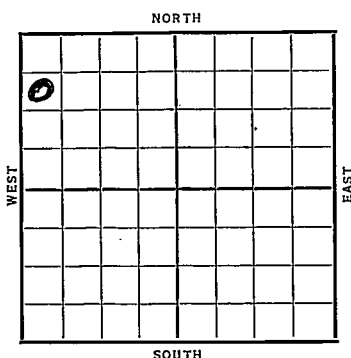

Date 1936

REPORT

9/2 Location.

9/10--

9/18 Rigging up.

9/24 13" @ 160". Waiting on cement.

10/1 Drilling 1800'.

10/8 Drllg. 3505'.

10/15 Sil. 3557'. Set 8". TD 3562'.
Waiting on cement.

10/22 3000' of oil 3562'.-68' TD.

10/28/36-Sil. 3563'.

T.D. 3568'.

Potential 965 bbls.

COMPLETED

Map No. 46 Sec. 32 Twp. 22 R. 11WWell No. #1 H. L. Har 8.Stans Lind Company

Contractor

SECTION PLAT

0			

990 Ft. from N. Line

_____ Ft. from S. Line

_____ Ft. from E. Line

330 Ft. from W. Line

FIRST REPORT

Location ✓

Rig up _____

Drilling and Remarks:

RECORD

Cased _____ in., _____ ft.

Sand _____

Gas _____

Oil _____

Total Depth _____

PRODUCTION

1st 24 hrs. Nat. _____

1st 24 hrs. after shot _____

Gas _____ Cu. Ft.

Dry Hole _____

Abandoned _____

Date

SEP 2 1936 ₁₉

S. J. LEWIS Scout

KANSAS

Map No. 46 Sec. 32 Twp. 22 R. 11WWell No. 1 Heyman CStandard Company

Contractor

SECTION PLAT

0			

990 Ft. from N. Line

_____ Ft. from S. Line

_____ Ft. from E. Line

830 Ft. from W. Line

CORRECTION

Location _____

Rig up _____

Drilling and Remarks:

*Reported
as No. 1 Hart*

RECORD

Cased _____ in., _____ ft.

Sand _____

Gas _____

Oil _____

Total Depth _____

• PRODUCTION

1st 24 hrs. Nat. _____

1st 24 hrs. after shot _____

Gas _____ Cu. Ft.

Dry Hole _____

Abandoned _____

Date

S. J. LEWIS

Scout

~~8~~ OCT 14 1938

Map No. 46 Sec. 32 Twp. 22 R. 11WWell No. 1 Heyman CStanford Company

Contractor

SECTION PLAT

0			

990 Ft. from N. Line

_____ Ft. from S. Line

_____ Ft. from E. Line

230 Ft. from W. Line

COMPLETED

Location _____

Rig up _____

Drilling and Remarks:

Oil 3568P 965

RECORD

Cased _____ in., _____ ft.

Sand _____

Gas _____

Oil _____

Total Depth 3568

PRODUCTION

1st 24 hrs. Nat. _____

1st 24 hrs. after shot _____

Gas _____ Cu. Ft.

Dry Hole _____

Abandoned _____

Date

OCT 28 1936

19

S. J. LEWIS Scout