

KANSAS Stafford

Section 32 Township 22 Range 11WWell No. 1 WellsCompany Virginia Drlg.

Richardson Pool

NORTH

WEST

EAST

SOUTH-

KANSAS

Stafford

Sec. 32 Twp. 22 R. 11W ✓

Well No. #1 Wells Farm

Virginia Drlg. Company

Richardson Pool


Ft. from N. Line

330' Ft. from S. Line

330' Ft. from E. Line

Ft. from W. Line

SE SW

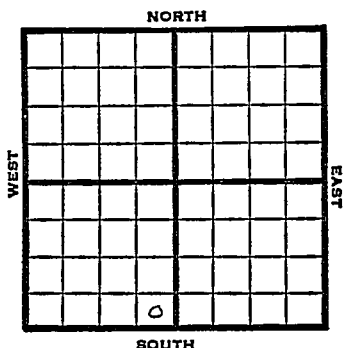

1948

Eli 1805'

R E P O R T

11/23

Location

11/30

8" @ 206'

Drlg 2293'

12/6

Lansing 3269'

Viola 3572'

Simpson Sd 3626'

Drlg. 3650'

12/15

TD 3715'

Arb. 3675'

Aband.

ABANDONED

Map No. _____ Sec. 32 Twp. 22 R. 11W

Well No. 1 Wells

Virginia Drlg. Company

FIRST REPORT

Contractor

SE SW

SECTION PLAT


_____ Ft. from N. Line

330 Ft. from S. Line

330 Ft. from E. Line

_____ Ft. from W. Line

Stafford County

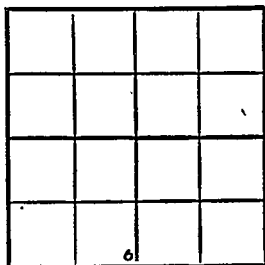

Location X

Rig up _____

Drilling and Remarks:

RECORD

Cased _____ in., _____ ft.

Sand _____

Gas _____

Oil _____

Total Depth _____

PRODUCTION

1st 24 hrs. Nat. _____

1st 24 hrs. after shot _____

Gas _____ Cu. Ft.

Dry Hole _____

Abandoned _____

Date

NOV 23 1948 19

S. J. LEWIS Scout

Map No. 46 Sec. 32 Twp. 22 R. 11W

Well No. 1 Wells

Virginia Drlg. Company

ABANDONED Contractor

SE SW

E1,1805
SECTION PLAT

 Ft. from N. Line

330 Ft. from S. Line

330 Ft. from E. Line

 Ft. from W. Line

Stafford County

Location

Rig up

Drilling and Remarks:

CR X3675

RECORD

Cased in., ft.

Sand

Gas

Oil

Total Depth 2215

PRODUCTION

1st 24 hrs. Nat.

1st 24 hrs. after shot

Gas Cu. Ft.

Dry Hole

Abandoned

Date

DEC 15 1948 19

S. J. LEWIS Scout