


Section 32 Township 22 Range 3W

Well No. #1 Forese

Company E. K. Carey et al

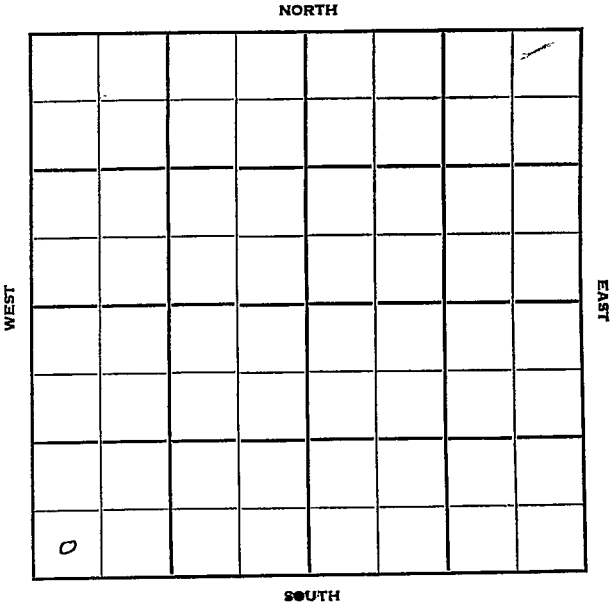

Harvey

KANSAS

Sec. 32 Twp. 22 R. 3W

Well No. #1 Froese Farm

E. K. Carey et al Company

Carey Drlg. Contractor

Burton Pgo


 Ft. from N. Line

330 Ft. from S. Line

 Ft. from E. Line

330 Ft. from W. Line

SW SW SW

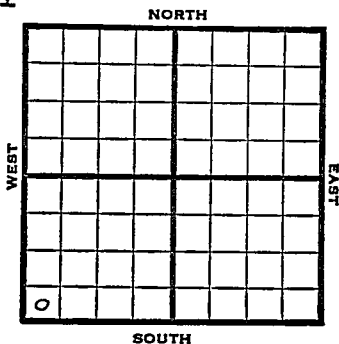

1951

Elev. 1460' REPORT

12/5

RUR

12/19

Spud 12-4-51

D & A TD 3400'

8" @ 280' Miss 3252'

DST 3270-95 open $\frac{1}{2}$ hr. rec 55' GCM

DST 3312-70 open $1\frac{1}{2}$ hr. rec 90' SOCM

TD 3400' D & A

ABANDONED

County **Harvey** State **Kansas**

Sec. **32** (Blk. Twp.) **22** (Sur. Rge.) **3W** Map No.

Operator **E. K. Carey et al.**

Well No. **1** Farm **Froese**

Elev.	Location
	SWST SW

FIRST REPORT

330 Ft. From S Line SW

330 Ft. From W Line Quarter

1st. Report DEC 5 1951

Completion

Remarks


Carey Drlg. - Contr.

Spudding Date _____

Drig. Data Burton Pool

R U R

County Harvey State Kansas
 Sec. 32 (Blk. 22) (Sur. 3W) Map No.
 Operator E. K. Carey et al.
 Well No. 1 Farm Froese
 Elev. 1460 Location SW SW SW

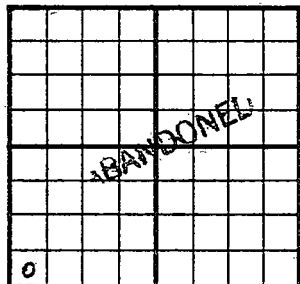

330 Ft. From S Line SW
330 Ft. From W Line Quarter
 1st. Report
 Completion DEC 1 9 1951
 Remarks Burrton Pool
Carey Drlg. - Contr.
 Spudding Date 12-4-51

Drlg. Data D & A TD 3400

8" @ 280 Miss. 3252 DST 3270-95

open $\frac{1}{2}$ hr. Rec. 55' gcm DST 3312-70

open $1\frac{1}{2}$ hr. Rec. 90' socm TD 3400

D & A