


Pawnee

KANSAS

SECTION 32 TOWNSHIP 22 RANGE 17 W

WELL NO. #2 Jordan

COMPANY Colo. O & G

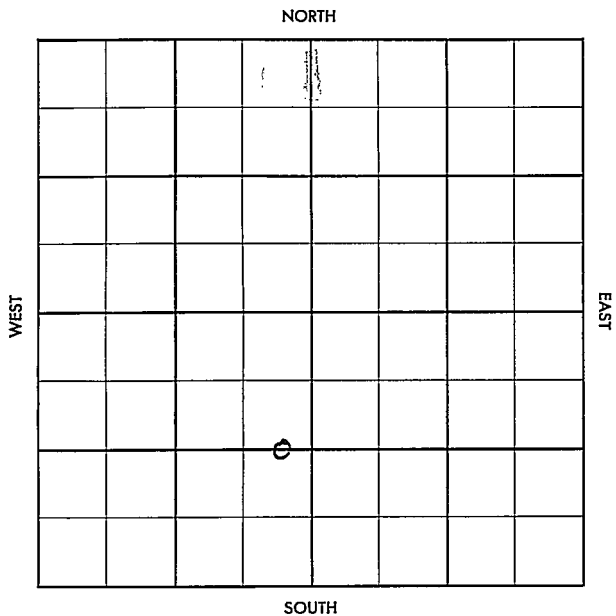

Pawnee

KANSAS

SEC. 32	TWP. 22	R. 17W
------------	------------	-----------

WELL NO. #2 Jordan FARM

COMPANY Colorado O&G

CONTRACTOR Wakefield

_____ Ft. from N. Line	
_____ Ft. from S. Line	
_____ Ft. from E. Line	
_____ Ft. from W. Line	

~~C E 1/2 E 1/2 SW~~

NE NWSW

	ELEVATION	REPORT
1956	2072'	
1-25	Comm. 1-23-56 8" @ 255/225 WOC	
3-14	DST 4175-96 op 1/2 hr. rec. 45' mud, 90/15" DST 4196-4220 op 1 hr. rec. 60' so&gcm 300/30" DST 4215-55 op 1 1/2 hr. rec. 180' so&gcm 470# 5 1/2" @ 4264 CO to 4235, 20/ 4217-22 B/ 30 gw 2 hrs., 500 A, frac F/ 8.18 boph, 8 hrs. Comp. F/138 bopd, 8% wtr. H. 3616 BL. 3718 L. 3726 C. Sh. 4144 Cg. Chert 4166 Cg. sd. 4218 V. 4232 TD 4265'	

COMPLETED

County Pawnee Elev. _____
 Sec. 32 Twp. 22 Rge. 17W
 Company Colorado O & G
 Farm Name Jordaan No. 2

TOPS	DEPTH	LOG	DATUM
Anh.			
Tr.			
H.			
Tr.			
Dg.			
Bl.			
L.			
K.C.			
B.K.C.			
Ce.			
C.			
M.			
M.			
K.			
Mz.			
Mq.			
V.			
S.			
S.			
A.			
R.			
PE.			
G.			
TD.			

Loc. in Sec. C E¹/₂ E¹/₂ SW
 Geol. _____
 Contr. Wakefield
 Pool Garfield

FIRST REPORT
 JAN 25 '56

Date Comm. 1-23-56
8" @ 255/225 WOC

(Large handwritten scribble)

Co.
 Use.
 No.
 Sec.
 T.
 R.

CORRECTION

FORM 513 REV. SUNRAY

County Pawnee Elev. _____
 Sec. 32 Twp. 22 Rge. 17W
 Company Colorado O & G
 FarmName Jordaan No. 2

TOPS	DEPTH	LOG	DATUM
Anh.			
Ip.			
H.			
Tr.			
Dg.			
Bl.			
L.			
K.C.			
B.K.C.			
Ce.			
C.			
M.			
M.			
K.			
Mz.			
Me.			
V.			
S.			
S.			
A.			
R.			
Pe.			
G.			
T.D.			

Loc. in Sec. _____
 NE NW SW
 Geol. _____
 Contr. _____
 Pool _____

CORRECTION			
0			

Date Comm. MAR 14 1956

Reported C E $\frac{1}{2}$ E $\frac{1}{2}$ SW

Co. Lse. No. Sec. T. R.

County Pardee Elev. 2072
 Sec. 32 Twp. 22 Rge. 17W
 Company Colorado O & G
 Farm Name Jordaan No. 2

TOPS	DEPTH	LOG	DATUM	Loc. in Sec.
Anh.				NE NW SW
Ip.				
H.	<u>3616</u>			
Tr.				
Dg.				
Bl.	<u>3718</u>			
L.	<u>3726</u>		<u>1654</u>	Geol.
K.C.				Contr.
B.K.C.				
Ce.				
C.	<u>4144</u>		<u>2072</u>	Wakefield
M.	<u>4166</u>		<u>2094</u>	Pool
M.	<u>4218</u>		<u>2146</u>	
K.				Garfield
Mz.				
Me.				
V.	<u>4232</u>		<u>2160</u>	COMPLETE
S.				
S.				
A.				
R.				
Pe.				
G.				
TD.	<u>4265</u>			

Date Comm. 1-23-56 MAR 14 1956

8" @ 255/225 DST 4175-96 open $\frac{1}{2}$ hr.

rec. 45' mud 90/15" DST 4196-4220

open 1 hr. rec. 60' so & gcm 300/30"

DST 4215-55 open $1\frac{1}{2}$ hr. rec. 180' so

& gcm 470# $5\frac{1}{2}$ " @ 4264 CO to 4235

20/ 4217-22 B/ 30 gw 2 hr. 500 A

frac F/ 8.18 hoph 8 hr.

Comp. F/ 138 bopd 8% wtr.