Pawnee


KANSAS

SECTION 32 TOWNSHIP 22S RANGE 20W

WELL NO. #1 Nolde

COMPANY D.E. Dunne, Jr.

NORTH SE NW NE

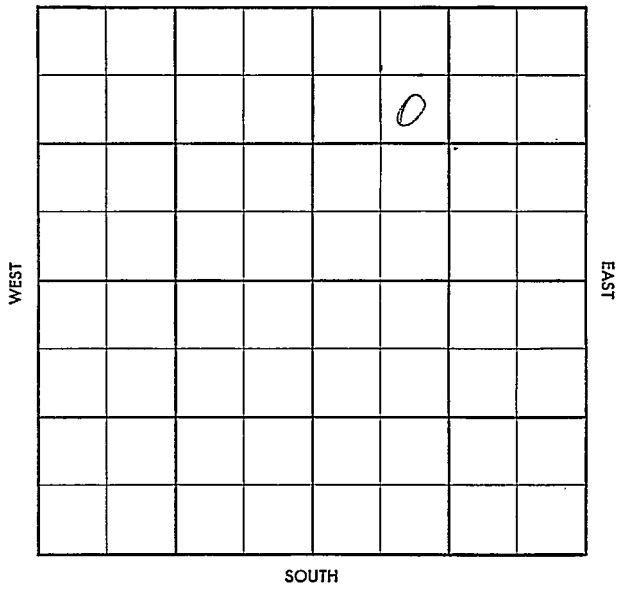

FORM 504-3 SUNRAY

WILDCAT

S-513-A

CO. Pawnee ELEV.

SEC. 32 TWP. 22 RGE. 20W FIRST REPORT

COMPANY D. E. Dunne, Jr. 1

DEC 4 '57

FARM Nolde

LOC. SE NW NE

GEOL.

CONTR. Twin Drlg.

POOL Wildcat

SPUD 12-1-57

8" @ 226/175

drlg. 1000

CO. LSE. NO. SEC. TWP. RGE.

S-513-A

CO. Pawnee ELEV. 2254 GR

SEC. 32 TWP. 22 RGE. 20W

COMPANY D. E. Dunne, Jr. No. 1

DEC 18 '57

ABANDONED

FARM Nolde

LOC. SE NW NE

GEOL.

CONTR. Twin Drlg.

POOL Wildcat

SPUD 12-1-57

8" @ 226/175

drlg. 1000

H 3878 (+1716)

BL 3961 L 3970

M 4518 (-2264) DST

4520-33 90"

22' oil & gas FP 25 B HP

65-50 TD 4615 Log Tops

H 3871 TR 3905 BL 3943

L 3958 (-1704) M 4518 K 4590

Ksd 4596 (-2342) -2264 -2336

D & A

CO. LSE. NO. SEC. TWP. RGE.