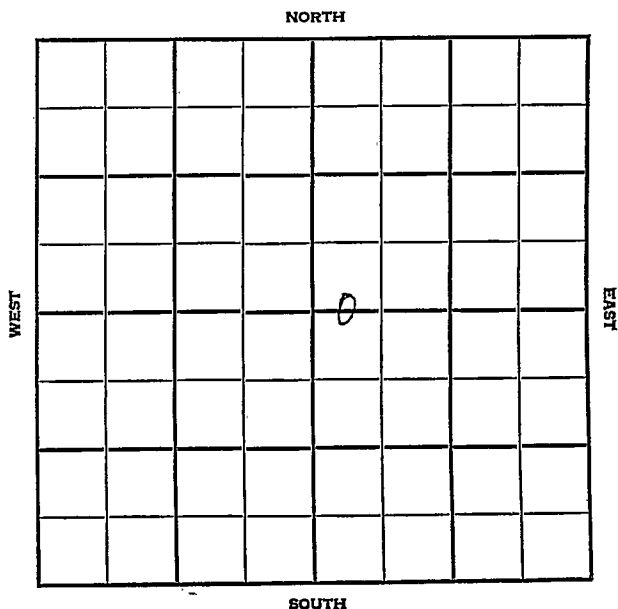


Section 32 Township 22 Range 32WWell No. #1 Jackson Gas UnitCompany Texas Company

Finney

KANSAS

SEC.	TWP.	R.
32	22	32W

WELL NO.

#1 Jackson Gas Unit

FARM

COMPANY

Texas Company

CONTRACTOR

Walter Kuhn


Hugontton

Ft. from N. Line

Ft. from S. Line

2340' Ft. from E. Line

Ft. from W. Line

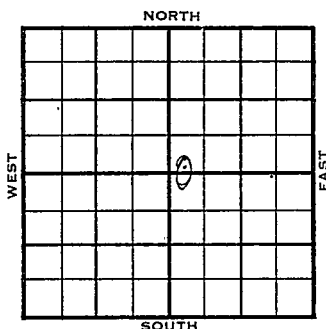~~###~~ C $W\frac{1}{2}$ $W\frac{1}{2}$ $E\frac{1}{2}$


1956

ELEVATION

2867'

REPORT

5- 16

Comm. 5-13-56

8" @ 535 w/350

Drlg. 535

6-13

5 $\frac{1}{2}$ " @2659 w/800

CO 2662

Tst. 5.434 MCF PB 2650 40/ 2616-26

64/ 2592-2608 ga 2.619 MCF

Frac gc 6.75 MCF ga 7.315 MCF

16/ 2566-70 ga 8.150 MCF,

200 A and Frac. G 7.804 MCF

51 24 hrs. G 11,665 MCF wet

G 15,110 MCF & 2 bw

SI worst

72/20

16.150 MCFG

Holl 2556', Herr 2590', Krl 2612'.

TD 2662'

COMPLETED

County Finney Elev. _____
 Sec. 32 Twp. 22 Rge. 32W
 Company Texas Company
 Farm Name Jackson Gas Unit No. 1

TOPS	DEPTH	LOG	DATUM	Loc. in Sec.
Anh.				C $W\frac{1}{2}$ $W\frac{1}{2}$ $E\frac{1}{2}$
T.P.				2340' EL
H.				
Tr.				
Dg.				
BL.				
L.				Geol. _____
K.C.				Contr. _____
B.K.C.				Walter Kuhn
Ce.				
C.				Pool
M.				Hugoton
M.				
K.				
Mz.				
Me.				
V.				
S.				
S.				
A.				
R.				
PE.				
G.				
T.D.				

FIRST REPORT
 MAY 16 '58

Date Comm. 5-13-56

8" @ 535/350 d rlg. 535

DEPT S S TAD

R. A.

FORM 513 SUNRAY

County Finney Elev. 2867
 Sec. 32 Twp. 22 Rge. 32W
 Company Texas Company
 Farm Name Jackson Gas Unit No. 1

TOPS	DEPTH	LOG	DATUM	Loc. in Sec.
Anh. <u>H811</u>	<u>2556</u>			<u>C W$\frac{1}{2}$ W$\frac{1}{2}$ E$\frac{1}{2}$</u> <u>2340' EL</u>
Tr. <u>H811</u>	<u>2590</u>			
H. <u>K11</u>	<u>2612</u>			
Tr.				
Dg.				
Bl.				
L.				
K.C.				Geol. _____
BXC.				Contr. _____
Ce.				<u>Walter Kuhn</u>
C.				
M.				Pool _____
M.				<u>Hugoton</u>
K.				
Mz.				
Me.				
V.				
S.				
S.				
A.				
R.				
Pe.				
G.				
T.D.	<u>2662</u>			

COMPLETE

JUN 13 '56

Date Comm. 5-13-56

8" @ 535/350 drlg. 535 MAY 23 '56

5 1/2 2659/800 MAY 29 '56 CO 2662

43T 5.434 MCF PB 2650 40/2616-26

64/2592. 2608 ga. 2.619 MCF FRAC

ga. 6.75 MCF ga. 7.315 MCF 16/

2566-70 ga. 8.150 MCF JUN 6 '56

200 A and Frac G 7,804 MCF

SI 24hrs G 11,665 MCF wet

G 15,110 MCF + 2BW SI wotest

FORM 513-1 SUNRAY

32-22-32 W C-112 8/12 E/

JUL 13 56

72/20

16,150 MCF6

\$