


Finney

Section 32 Township 22 Range 33WWell No. #1 HorningCompany Kansas-Nebraska

NORTH

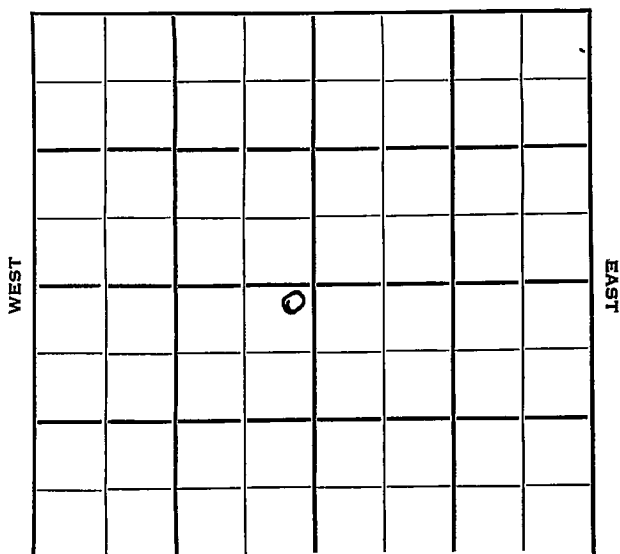

SOUTH

Finney

FORM 252-B

KANSAS ✓

Sec. 32 Twp. 22 R. 33W

Well No. #1 Horning Farm

Kansas-Nebraska Company

Contractor


200 Ft. from N. Line

Ft. from S. Line

200 Ft. from E. Line

Ft. from W. Line

NE SW

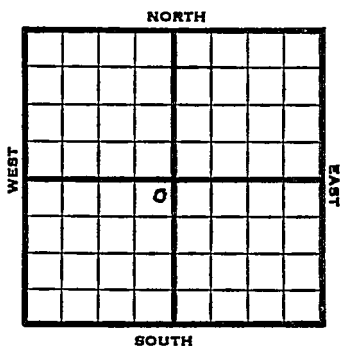

1953 Elev. 2900' REPORT

7/29 Spud 7-12-53
10" @ 304'
TD 2630'
7" @ 2625'
WOC

8/12 CO 2620, 216/2528-64, 192/2578-2610

8/19 Her Kr 2528, Win 2578
7000 frac 7000A

8/26 NR

10/7 Spud 7-12-53 Gas well TD 2630
10" @ 304' TD 2630 7" @ 2625
CO to 2620 216/2528-64 192/2578-
2610 Her. 2528 Win. 2578
7000 frac. 7000 A
Comp. 2,898,000 gas.

COMPLETED

County Finney State Kansas

Sec. 32 (Blk. Twp.) 22 (Sur. Rge.) 33W Map No.

Operator **Kansas-Nebraska**

Well No. **1** Farm **Hopline**

Elev.	Location	NE	SW
-------	----------	----	----

[illegible]

200 Ft. From N Line SW

200 Ft. From E Line Quarter

1st. Report JUL 20 1953

Completion

Remarks

Spudding Date **7-12-53**

Drlg. Data

10" @ 304 TD 2630 7" @ 2625 WOC

J. G. McGEHEE

County Finney State Kansas
 Sec. 32 (Blk. 22) (Sur. 33W) Map No.
 Operator Kansas-Nebraska
 Well No. 1 Farm Horning
 Elev. 2900 Location NE SW

COMPLETE

200 Ft. From N Line SW
200 Ft. From E Line Quarter
 Ist. Report 001 7 1953
 Completion
 Remarks

 Spudding Date 7-12-53

Drlg. Data Gas well TD 2630
10" @ 304 TD 2630 7" @ 2625
CO to 2620 216/2528-64 192/ 2578-2610
Her. 2528 Win. 2528 7000 frac 7000 A
Comp. 2,898,000 gas

J. G. McGEHEE