


Section 32 Township 22 Range 35W

Well No. 1 Bentley

Company Stanolind Oil and Gas Company

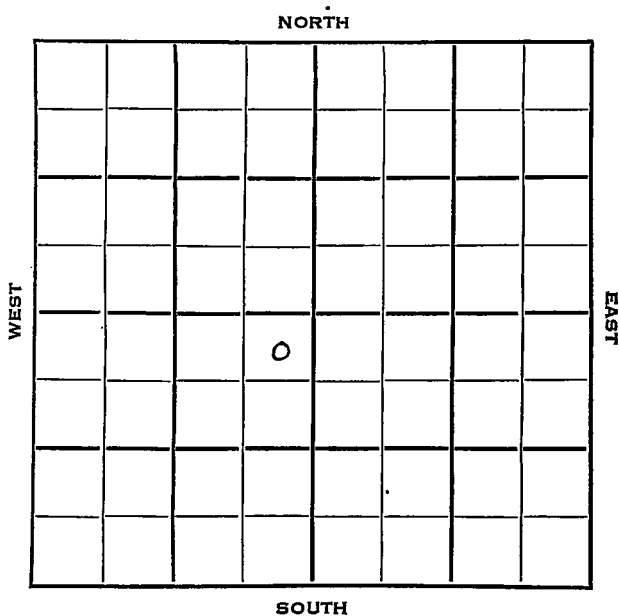

Sec. 32 Twp. 22 R. 35W

Well No. #1 Bentley Farm _____

Stanolind Company _____

Contractor _____


150 Ft. from N. Line

_____ Ft. from S. Line

150 Ft. from E. Line

_____ Ft. from W. Line

NE SW

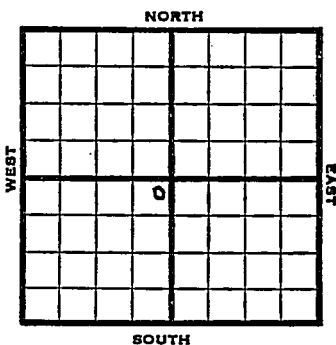

1953 Elev. 3112' REPORT

1/14 Location

1/22 "

1/29 "

2/5 "

2/12 "

2/19 "

2/26 Location

3/12 8" @ 864 w/500

RTD 2670

5" @ 2643

~~3/19~~ NR

3/26 CO 2670' Dol-frac. PB 2635
 36/2585-91' 30/2593-98 24/2602-06
 24/2610-14 12/2617-19
 Kri 2601'

4/1 Spud 3-4-53 Gas well TD 2670
 8" @ 864 Her. 2585 Kri. 2601
 Win 2643 TD 2670 5" @ 2643
 CO to 2670 dol-frac. PB 2635
 36/2585-91 30/2593-98 24/2602-06
 24/2610-14 12/2617-19 dol-frac.
 CO to 2670
 Comp. 3,652,000 gas. 310#

COMPLETED

