

KANE

Stafford

FORM 51 25M 3-49 PETROL

Section 33 Township 22 Range 12-WWell No. #1 SpangenbergCompany B & B Drlg

NORTH

			6				

WEST

EAST

SOUTH

KANSAS

Stafford

Sec. 33 Twp. 22 R. 12-W

Well No. #1 Spangenberg Farm

B & B Drlg Company

Contractor

Wildcat


330 Ft. from N. Line

Ft. from S. Line

330 Ft. from E. Line

Ft. from W. Line

NE NE NW

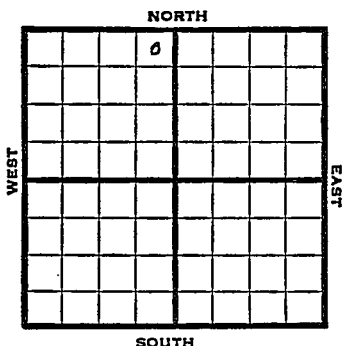

1956

Elev 1852'

REPORT

2/15

Spud 2-10-50

8" @ 243'

Anhy 650

Drlg 1689'

3/8

TD 3732'

8" @ 243'

5" @ 3704'

Lans 3301'

Viola 3594'

Simp 3637'

Arb. 3703'

D&A

Aband.

ABANDONED

Map No. _____ Sec. 33 Twp. 22 R. 12WWell No. 1 SpangenbergR & B Drlg.

Company _____

Contractor _____

NE NE NW

El. 1852


SECTION PLAT

330 Ft. from N. Line

_____ Ft. from S. Line

330 Ft. from E. Line

_____ Ft. from W. Line

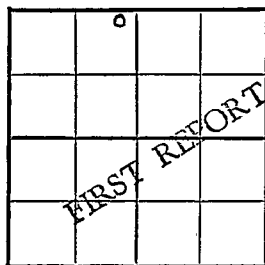Stafford CountySunray DHM

Location _____

Rig up _____

Drilling and Remarks:

Spud 2-10-50

8" @ 243

Anhy 650

drlg. 1689

RECORD

Cased _____ in., _____ ft.

Sand _____

Gas _____

Oil _____

Total Depth _____

PRODUCTION

1st 24 hrs. Nat. _____

1st 24 hrs. after shot _____

Gas _____ Cu. Ft.

Dry Hole _____

Abandoned _____

Date

FEB 15 195019J. E. TYRA

Scout

Map No. _____ Sec. 33 Twp. 22 R. 12WWell No. 1 Spangenberg

_____ B & B Drlg. _____ Company

_____ Contractor


NE NE NW

E. 1852
SECTION PLAT330 Ft. from N. Line

_____ Ft. from S. Line

330 Ft. from E. Line

_____ Ft. from W. Line

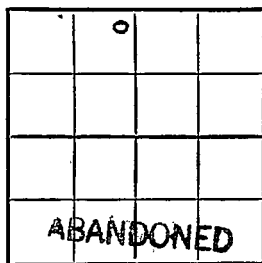

Stafford County

Location _____

Rig up _____

Drilling and Remarks:

8" @ 243

5" @ 370+

Kans 3301

Viola 3594

Simp 3637

arb 3703

RECORD

Cased _____ in., _____ ft.

Sand _____

Gas _____

Oil _____

Total Depth 3732

PRODUCTION

1st 24 hrs. Nat. _____

1st 24 hrs. after shot _____

Gas _____ Cu. Ft.

Dry Hole _____

Abandoned _____

Date

D+A

MAR 8 1950 19

J. E. TYRA

Scout