


Section 33 Township 22 Range 13-W

Well No. #1 Durham

Company Virginia Drlg.

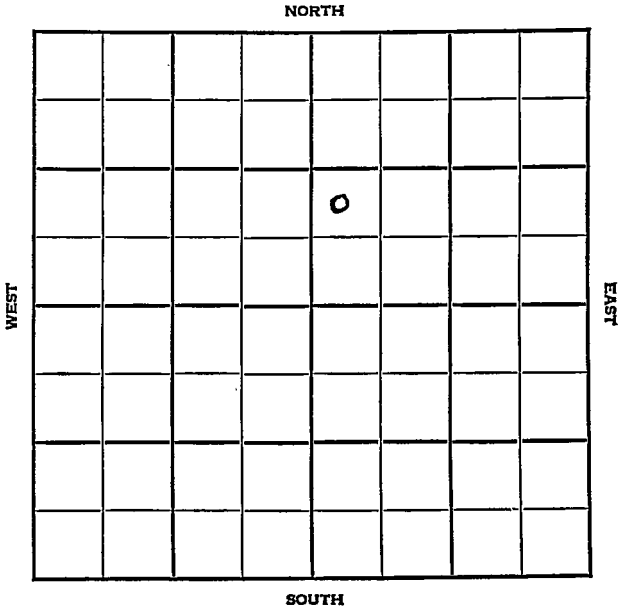



Sec. 33 Twp. 22 R. 13W

Well No. #1 Durham Farm

Virginia Drlg. Company


Wildcat

 Ft. from N. Line

990 Ft. from S. Line

 Ft. from E. Line

330 Ft. from W. Line

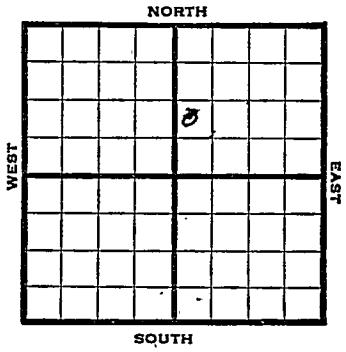

NW SW NE

1947	Elev. 1902' REPORT
12/3	Location
12/10	RUR
12/17	8" @ 285'
1948	.
1/7	Viola 3763' Simp. 3826' Arb. 3881' Total Depth 3912' ABANDONED

Map No. _____ Sec. 33 Twp. 22 R. 13W

Well No. 1 Durham

Virginia Drlg. Company

FIRST REPORT Contractor

NW SW NE

SECTION PLAT

_____ Ft. from N. Line

990 Ft. from S. Line

_____ Ft. from E. Line

330 Ft. from W. Line

		o	

Stafford County

Location X

Rig up _____

Drilling and Remarks:

RECORD

Cased _____ in., _____ ft.

Sand _____

Gas _____

Oil _____

Total Depth _____

PRODUCTION

1st 24 hrs. Nat. _____

1st 24 hrs. after shot _____

Gas _____ Cu. Ft.

Dry Hole _____

Abandoned _____

Date

DEC 3 1947 19 _____

S. J. LEWIS Scout

