


Section 33 Township 22 Range 14 W

Well No. # 1 Ryal Miller

Company Sunray Oil

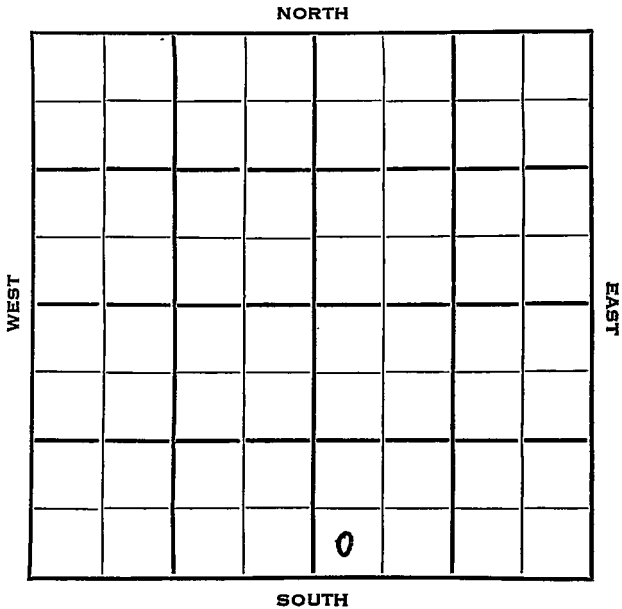

Stafford

KANSAS

SEC.	TWP.	R.
33	22	14W ✓
WELL NO.		
1 Ryal Miller		
COMPANY		FARM
Sunray Oil		
CONTRACTOR		

Ft. from N. Line

330


Ft. from S. Line

Ft. from E. Line

330

Ft. from W. Line

SW SW SE

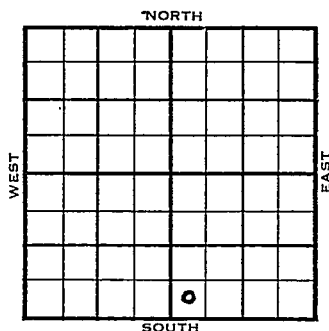

1953

ELEVATION

1951'

REPORT

10/28

WOC

11/4

8" @ 985'

11/11

N.R.

12/9

8" @ 239' w/200

Heeb 3387', Tor 3406', Br li 3516',
KC 3523'

DST 3638-55', 1 hr., 15' SOCM,

Cong 3856', V 3868', Simp 3907'

DST 3926-46', 1 hr., 30' M, 60'

SOCM, 60' HOCM, 280' oil, 20' ? wtr.
670#

DST 3956-61', 1 hrs., 20' M

Arh. 3974'

RTD 3979' Schl

5" @ 3978'

12/16

CO 3964 20/3934-39 14 GOPH
4 hrs. 500 A S/139 BO 7 hrs.

12/30

Spud 11-22-53 Oil well TD 3979

8" @ 239 Heeb 3387 Tor. 3401

Br. lime 3516 KC 3523'

DST 3638-55 open 1 hr rec 15' SOCM off

Cong. 3856 Viola 3868 Simp. 3907

DST 3926-46 open 1 hr rec 30' mud;
60' SOCM, 60' HOCM, 280' oil, 20' wtr.
670#

OVER

1953

12/30

(Information continued)

DST 3956-61 open 1 hr rec 20' mud

40# Arb. 3974 TD 3979

5" @ 3978 CO to 3964 20/3934-39


14 BOPH 4 hr. 500 A S/139 BO

7 hr.

Comp. 200 BOPD

COMPLETED

J. G. McGEHEE

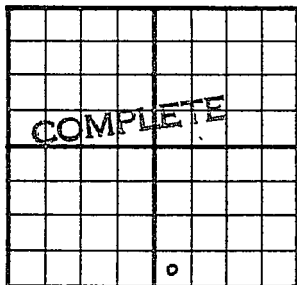County Stafford State KansasSec. 33 (Blk. 22 (Sur. 14W Map No.Operator Sunray OilWell No. 1 Farm Ryal MillerElev. 1951 Location SW SW SE330 Ft. From S Line SE330 Ft. From W Line Quarter

1st. Report

Completion DEC 30 1953

Remarks

Spudding Date 11-22-53Drlg. Data Oil well TD 39798" @ 239 Heeb. 3387 Tor. 3401Br. lime 3516 KC 3523 DST 3638-55open 1 hr. Rec. 15' socm 0#Comp. 3856 Viola 3868 Simp. 3907DST 3926-46 open 1 hr. Rec. 30' mud60' socm 60' hocm 280' oil 20' wtr.670# DST 3956-61 open 1 hr. Rec. 20'mud 40# Arb. 3974 TD 3979 5" @ 3978CO to 3964 20/ 3934-39 14 goph 4 hr.500 A S/ 139 bo 7 hr.Comp. 200 bopd

J. G. McGEHEE