


Section 33 Township 22 Range 15W

Well No. #1 Fergus

Company Icer Addis & H. Miller

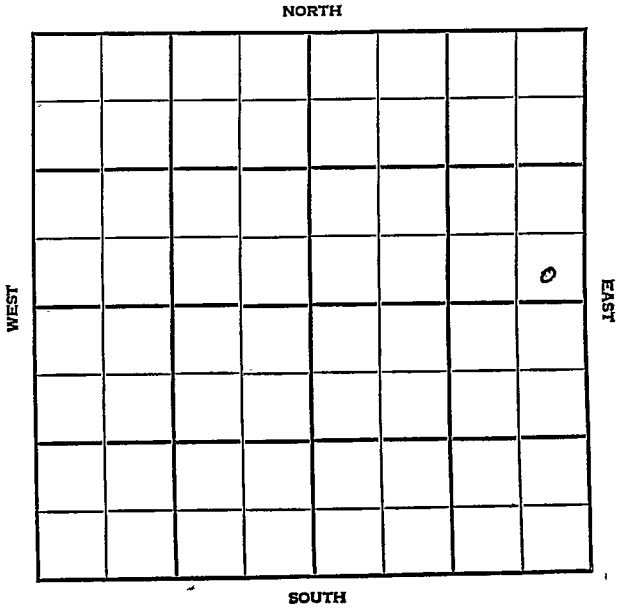

Pawnee KANSAS

SEC.	TWP.	R.
33	22	15W

WELL NO. 1 Fergus FARM

COMPANY Icer Addis & H. Miller

CONTRACTOR Mast Drlg.

Wildcat


_____ Ft. from N. Line

330 _____ Ft. from S. Line

330 _____ Ft. from E. Line

_____ Ft. from W. Line

SE SE NE

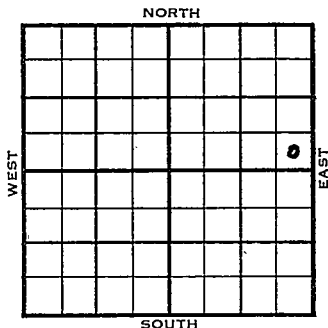

1955	ELEVATION 2002'	REPORT
------	-----------------	--------

3/2 Spud 2-26-55
8" @ 209'
Drlg. 2000'

3/16 Spud 2-26-55, D&A, TD 4121
8" @ 209, Heeb 3456, Br Lime
3576, Lans 3584, Cong 3899,
Viola 3919, Simp 4025, Simp Sd
4063, Arb 4114, TD 4121
D&A

ABANDONED

County **Pawnee** State **Kansas**
 Sec. **35** (**Blk.**) **22** (**Sur.**) **15W** Map No.
30 (**Twp.**)
 Operator **Icer Addis & H. Miller**
 Well No. **1** Farm **Fergus**
 Elev. Location **SE SE NE**

330 Ft. From S Line NE
330 Ft. From E Line Quarter
 1st. Report **MAR 2 1955**
 Completion
 Remarks
Mast Drlg. - Contr.
 Spudding Date **2-26-55**

Drlg. Data **Wildcat**
8" @ 209 drlg. 2000

FABEN GILSTRAP

County Pawnee State Kansas

Sec. 33 (Blk. 22 (Sur. 15W (Twp.) Rge.) Map No.

Operator Icer Addis & H. Miller

Well No. 1 Farm Fergus

Elev. 2002 Location SE SE NE

330 Ft. From S Line NE

330 Ft. From E Line Quarter

1st. Report

Completion MAR 1 6 1955

Remarks Wildcat

Mast Drlg. - Contr.

Spudding Date 2-26-55

Drlg. Data D & A TD 4121

8" @ 209 Heeb. 3456 Br. lime 3576

Lans. 3584 Cong. 3899 Viola 3919

Simp. 4025 Simp. sd. 4063 Arb. 4114

TD 4121

D & A

FABEN GILSTRA