


Section 33 Township 22 Range 15W

Well No. #2 Koelsch

Company Natural Gas & Oil

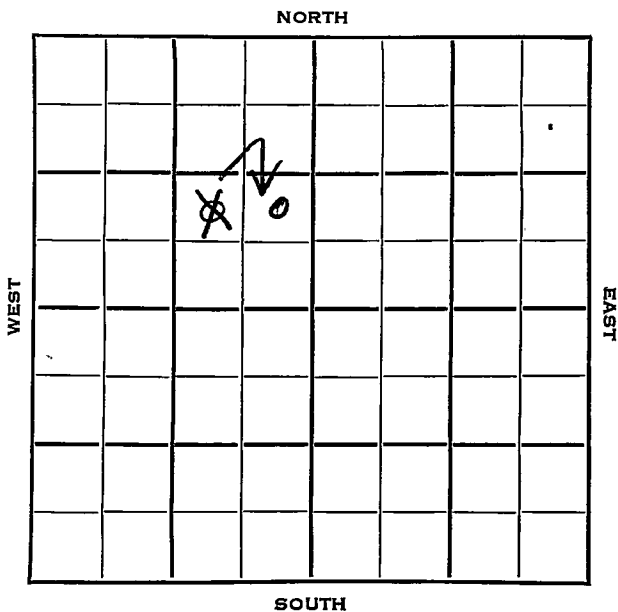

Sec. 33 Twp. 22 R. 15 W

Well No. # 2 Koelsch Farm

Natural Gas & Oil Company

Contractor


Ft. from N. Line

990 Ft. from S. Line

330
~~990~~ Ft. from E. Line

Ft. from W. Line

NE SE NW
NW SE NW

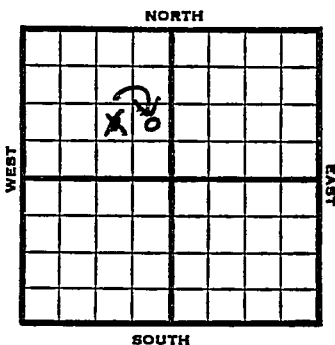

1953 Elev. 2002' REPORT

8/19 Drilling

8/26 8" @ 199
Anhy 945'
Drlg. 3280'

9/2 Heeb 3438, Br. L. 3558, KC 3566,
DST 3623-42 1 hr, 60' OCM, 60' WCM,
1210# B KC 3800, Cong 3889, V 3963,
DST 3707'-42' 1 hr, 240' Wtr. 120'
SOCW, 1040#
Drlg 4008'

9/9 Arb 4074'
DST 4011-71 1 hr, 35' M.

9/16 Spud 8-13-53
D & A
TD 4079'
8" @ 199'
Anhy 945, Heeb 3438, Br. Lime 3558,
KC 3566
DST 3623-42 opn 1 hr, rec 60' socm
60' wcm 1210# B KC 3800, Cong 3889
Viola 3936
DST 3707-42 opn 1 hr, rec 240' wtr,
120' socw 1040# Arb 4074
DST 4011-71 opn 1 hr, rec 35' mud
TD 4079'
D & A

ABANDONED

Kansas

Map No. _____ Sec. 33 Twp. 22 R. 15W

Well No. 2 Koelsch

Natural Gas & Oil _____ Company

CORRECTION

Contractor _____

NE SE NW

SECTION PLAT

_____ Ft. from N. Line

990 Ft. from S. Line

330 Ft. from E. Line

_____ Ft. from W. Line

	•		

Pawnee County

Location _____

Rig up _____

Drilling and Remarks:

Reported
NW SE NW

RECORD

Cased _____ in., _____ ft.

Sand _____

Gas _____

Oil _____

Total Depth _____

PRODUCTION

1st 24 hrs. Nat. _____

1st 24 hrs. after shot _____

Gas _____ Cu. Ft.

Dry Hole _____

Abandoned _____

Date

AUG 28 1953

J. G. McGEHEE

Scout


County Pawnee State Kansas

Sec. 33 (Blk. Twp.) 22 (Sur. Rge.) 15W Map No.

Operator Natural Gas & Oil

Well No. 2 Farm Koelsch

Elev. 2002 Location NE SE NW

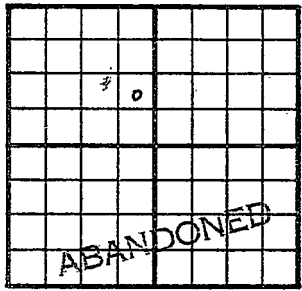

990 Ft. From S Line NW

330 Ft. From E Line Quarter

Ist. Report

Completion SEP 16 1953

Remarks

Spudding Date 8-13-53

Drlg. Data D & A TD 4079

8" @ 199 Anhy 945 Heeb. 3438

Br. lime 3558 KC 3566 DST 3623-42

open 1 hr. Rec. 60' socm 60' wcm

1210# B KC 3800 Cong. 3889 Viola 3936

DST 3707-42 open 1 hr. Rec. 240' wtr.

120' socw 1040# Arb. 4074 DST 4011-71

open 1 hr. Rec. 35' mud TD 4079

D & A

J. G. McGEHEE