

Pawnee


KANSAS

SECTION 33 TOWNSHIP 22 RANGE 15 W

WELL NO. #2 Fergus "A"

COMPANY Phillips Pet.

NORTH

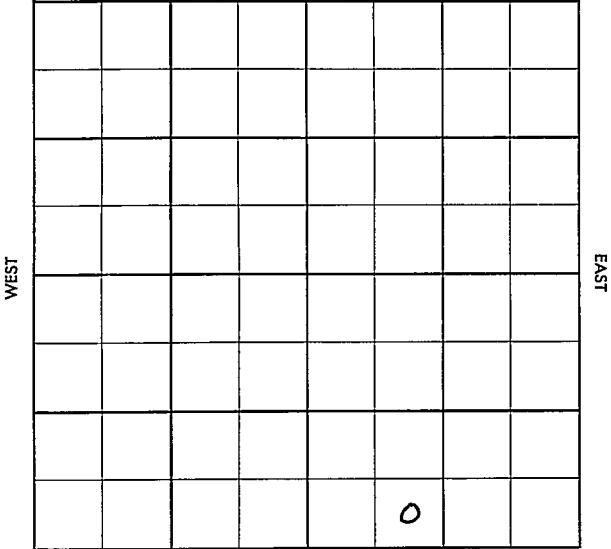

SOUTH

County Paawnee Elev. _____
 Sec. 33 Twp. 22 Rgs. 15W
 Company Phillips Pet.
 Farm Name Fergus "A" No. 2

TOPS	DEPTH	LOG	DATUM
Anh.			
Tr.			
H.			
Tr.			
Dg.			
Bl.			
L.			
K.C.			
B.K.C.			
Ce.			
C.			
M.			
M.			
K.			
Mz.			
Me.			
V.			
S.			
S.			
A.			
R.			
Pe.			
G.			
T.D.			

Loc. in Sec. SE SW SE

Geol. _____

Contr. _____

Co. tools

Pool _____

Jay

FIRST REPORT		
	JAN 5 '36	
		0

Date Comm. 12-30-55

9" @ 663/415 orlg. 2230


Co.

Lse.

No.

Sec.

T.

R.

County Pawnee Elev. 2011
 Sec. 33 Twp. 22 Rge. 15W
 Company Phillips Pet.
 FarmName Fergus "A" No. 2

TOPS	DEPTH	LOG	DATUM
Anh.			
Tr.			
H.	3451	3450	
Tr.	3471	3470	
Dg.	3486		
Bl.	3572	3574	
L.	3580	3583	1572
K.C.			
B.K.C.	3827	3830	1819
Ce. <u>Manam</u>	3837	3840	1829
C. <u>Detri</u>	3904		1895
M.	3926	3929	1918
M.			
K.			
Mz.			
Ma.			
V.	3962	3951	1950
S. <u>sh</u>	4023	4028	2017
S. <u>sl</u>	4025	4034	2023
A.	4082	4083	2072
R.			
Pe.			
G.			
T.D.	4100		

Loc. in Sec. SE SW SE
 Geol. _____
 Contr. _____
 Co. tools _____
 Pool Jay

ABANDONED

Date Comm. 12-30-55 JAN 18 1956
9" @ 663/415 DST 4022-53 open 1 hr.
rec. 5' gassy mud 0/15"

D & A

Co.
 Lse.
 No.
 Sec.
 T.
 R.