


Section 33 Township 22 Range 15W

Well No. 1 Ratzlaff

Company Natural Gas & Oil & Okla. Explr.

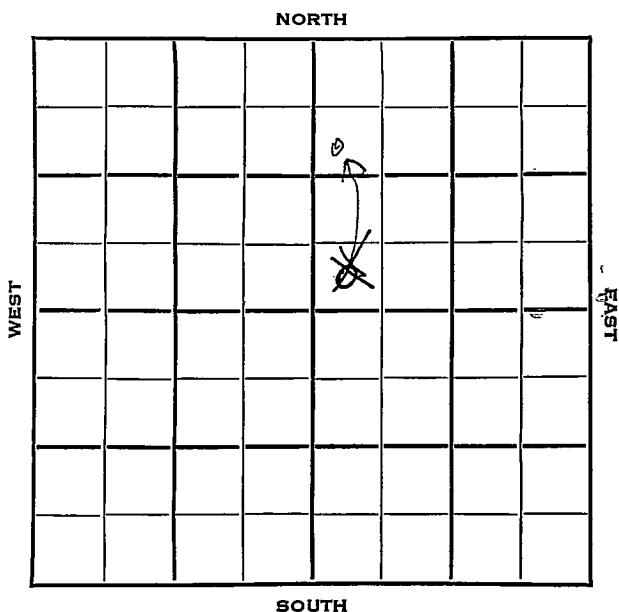

Pawnee

KANSAS

SEC.	TWP.	R.
33	22	15 W

WELL NO.

I Ratalaff

FARM

COMPANY

Natural Gas & Oil & Okla. Explor.

CONTRACTOR

Co. tools

990 Ft. from N. Line


330 Ft. from S. Line

Ft. from E. Line

330 Ft. from W. Line

~~SW SW NE~~

SW NW NE

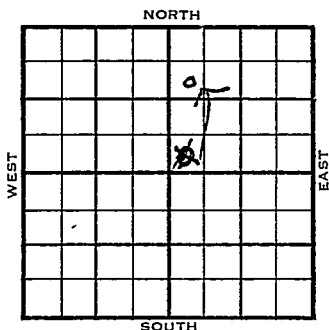

1953

ELEVATION

2005'

REPORT

11/11

Drlg.

11/18

10" @ 199'

Drlg 3390'

11/24

Spud 11-8-53

D & A TD 4109' 10" @ 199

Anhy 952 Heeb 3443 Br lime 3563

KC 3576 B KC 3806 Cong 3888

Arb. 4089 TD 4109 D & A

ABANDONED

Kansas

Map No. _____ Sec. 33 Twp. 22 R. 15WWell No. 1 RatzlaffNatural Gas & Oil & Okla. Expl. CompanyCORRECTION Contractor

SW NW NE

SECTION PLAT

990 Ft. from N. Line

_____ Ft. from S. Line

_____ Ft. from E. Line

330 Ft. from W. Line

		6	

Pawnee County

Location _____

Rig up _____

Drilling and Remarks:

Reported
SW SW NE

RECORD

Cased _____ in., _____ ft.

Sand _____

Gas _____

Oil _____

Total Depth _____

PRODUCTION

1st 24 hrs. Nat. _____

1st 24 hrs. after shot _____

Gas _____ Cu. Ft.

Dry Hole _____

Abandoned _____

Date

NOV 18 1953 19

J. G. MCGEHEE Scout

