





KANSAS

Sec. 33 Twp. 22 R. 11W

Well No. #1 Fitzmeyer Farm

McCole et al Company

Wildcat


           Ft. from N. Line

330 Ft. from S. Line

           Ft. from E. Line

330 Ft. from W. Line

SW/C

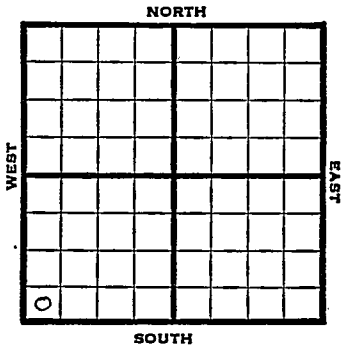

1948 Elev. 1803' REPORT

- 4/21 8" @ 239'  
WOC
- 4/28 Drlg. 2940'
- 5/5 Lans. 3266'  
Viola 3601'  
Arbuckle 3689'  
TD 3729'

**ABANDONED**

Map No. \_\_\_\_\_ Sec. 33 Twp. 22 R. 11W

Well No. 1 Fitzmeyer

McCole etal. Company

**FIRST REPORT** Contractor

SW/C

SECTION PLAT


\_\_\_\_\_ Ft. from N. Line

330 Ft. from S. Line

\_\_\_\_\_ Ft. from E. Line

330 Ft. from W. Line

Stafford County

Location \_\_\_\_\_

Rig up \_\_\_\_\_

Drilling and Remarks:

8" @ 239 WOC

RECORD

Cased \_\_\_\_\_ in., \_\_\_\_\_ ft.

Sand \_\_\_\_\_

Gas \_\_\_\_\_

Oil \_\_\_\_\_

Total Depth \_\_\_\_\_

PRODUCTION

1st 24 hrs. Nat. \_\_\_\_\_

1st 24 hrs. after shot \_\_\_\_\_

Gas \_\_\_\_\_ Cu. Ft.

Dry Hole \_\_\_\_\_

Abandoned \_\_\_\_\_

Date

APR 21 1948 19 \_\_\_\_\_ S. J. LEWIS Scout

