

Section 33 Township 22 Range 11 WWell No. # 1 FitzmeyerCompany Petroleum Inc.

NORTH

		0					


WEST

EAST

SOUTH

Sec. 33 Twp. 22 R. 11WWell No. 1 Fitzmeyer FarmPetroleum Inc. CompanyGarvie ContractorWildcat Ft. from N. Line330 Ft. from S. Line990 Ft. from E. Line Ft. from W. Line

SW SE NW

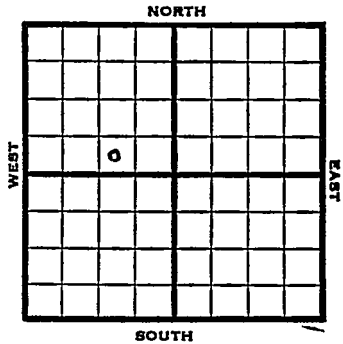

1953 Elev. 1800' REPORT

4/15 Spud 4-11-53
 8" @ 220
 Anhy 530
 Drlg 11753'

4/23 Drlg 3571'

4/29 Spud 4-11-53
 D & A
 TD 3641'
 8" @ 220'
 Anhy 530, Heeb 3066, Br. Lime 3207,
 Lans 3226,
 DST 3241-83 opn 1 $\frac{1}{4}$ hr. Rec 60' o & gcm
 100#
 DST 3424-47 opn 1 hr, rec 150' vso &
 gcm 300' ocw, 120' wtr. 1175#
 Cong 3526, Viola 3532,
 DST 3486-3564 opn 1 hr, rec 55' mud,
 125# Simp 3571,
 DST 3559-92 opn 1 hr, rec 1080' gas
 125' so & gcm 185#
 DST 3581-3607 open 40 min, rec 20' mud,
 Arb 3633,
 DST 3583-3641 opn 1 hr, rec 160' mcw
 240' wtr.
 D & A

ABANDONED

County **Stafford** State **Kansas**

Sec. **33** (Blk. **22** (Sur. **11W** Map No.

Operator **Petroleum Inc.**

Well No. 7 Farm Fitzmeyer

Elev.	Location	SW	SE	NW
-------	----------	----	----	----

0

FIRST REPORT

330 Ft. From S Line NW

990 Ft. From E Line Quarter

1st. Report APR 15 1953

Completion

Remarks

Garvie - Contr.

Spudding Date **4-11-53**

Drlg. Data Wildcat

8" @ 220 Anhv 530 drlg. 1753

