


DX 78-1 Pawnee

KANSAS

Section 33 Township 22 Range 17W

Well No. #1 Hutchinson "G"

Company Honaker Drlg & NCRA

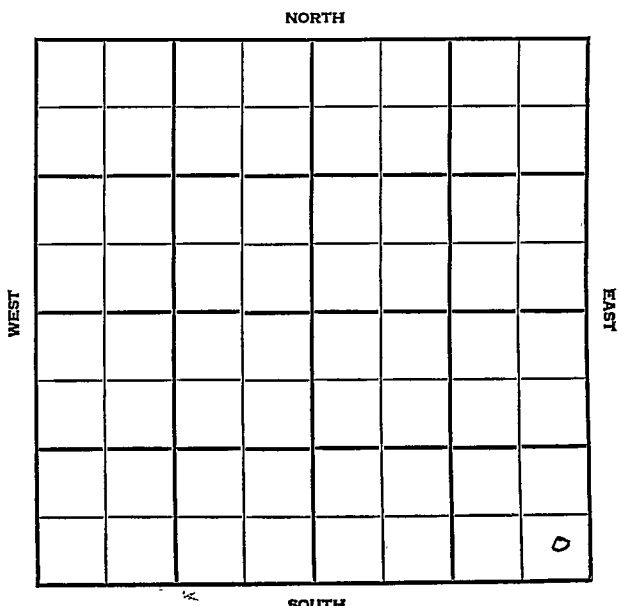

SEC.	TWP.	R.
33	22	17W

WELL NO.

#1 Hutchinson "G"

FARM

COMPANY

Honaker Drlg. & NCRA

CONTRACTOR

Co.Tools.

Garfield Pool

NORTH

Ft. from N. Line

330 _____ Ft. from S. Line

330 _____ Ft. from E. Line

_____ Ft. from W. Line

SE SE SE


1954	ELEVATION 2052'	REPORT
11/17	Spud 11-11-54 8" @ 205' Anhy 1125' Drlg. 2295'	
1955 3/30	Spud 11-11-54 - SI Gas Well TD 4260' 8" @ 205' Anhy 1125', Br lime 3681', Lans. 3690', Cong. 4095' DST 4100-12, opnl hr., gas in 10", 3,690,000 cfig, 30' sw, 1400# DST 4129-41, opn 1 hr., rec. 30' mud, 1220# DST 4148-88, misrun DST 4153-88', opn 2 hrs., rec. 60' mud 100# TD 4260' X 5" @ 4259', CO, 18/4182-90 Sd-frac, S 3/4 bo 2-3/4 bwph 4 hrs. 28/4158-62, 2 1/2 go 2 gwph frac 48/4119-36; frac Viola 4239', Cong. 4100', Ch Cong 4117' F/25 bopd 4,000,000 cfig, 30/4136-40 frac Comp. 4,000,000 cfcpd, SI GAS WELL	

COMPLETED

County **Pawnee** State **Kansas**

Sec. **33** (Blk. Twp.) **22** (Sur. Rge.) **17W** Map No.

Operator Honaker Drig. & NCRA

Well No. **1** Farm **Hutchinson "G"**

Elev. 2052 Location SE SE SE

FIRST REPORT

330 Ft. From S Line SE

330 Ft. From E Line Quarter

1st. Report NOV 17 1954

Completion

Remarks

Co. tools


Spudding Date **11-11-54**

Drbg. Data: Garfield Pool

8ⁿ @ 205 Anhy 1125 drlg. 2295

FABEN GILSTRAP

County Pawnee State Kansas
 Sec. 33 (Blk.) 22 (Sur.) 17W Map No.
 Operator Honaker Drlg. & NCRA
 Well No. 1 Farm Hutchinson "G"
 Elev. 2052 Location SE SE SE

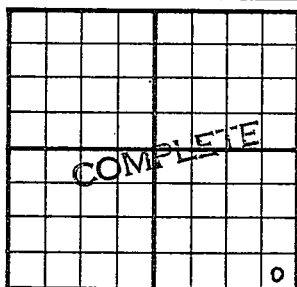

330 Ft. From S Line SE
330 Ft. From E Line Quarter

1st. Report

Completion MAR 30 1955

Remarks Garfield Pool

Co. tools

Spudding Date 11-11-54

Drlg. Data SI gas well TD 4260
8" @ 205 Anhy 1125 Br. lime 3681
Lans. 3690 Cong. 4095 DST 4100-12
open 1 hr. gas in 10 min. 3,690,000 cfg
30' sw 1400# DST 4129-41 open 1 hr.
Rec. 30' mud 1220# DST 4148-88 misrun
DST 4153-88 open 2 hr. Rec. 60' mud
100# TD 4260 5" @ 4259 CO 18/ 4182-
90 sd-frac S/ 3/4 bo 2 3/4 bwph
4 hr. 28/ 4158-62 2 1/2 go 2 gwph
frac 48/ 4119-36 frac Viola 4239
Cong. 4100 Ch. Cong. 4117 F/ 25 bopd
4,000,000 cfg 30/ 4136-40 frac
Comp. 4,000,000 cfcpd SI gas well

FABEN GILSTRAP